


T.34 S.R.1 & 2 W.W.M.

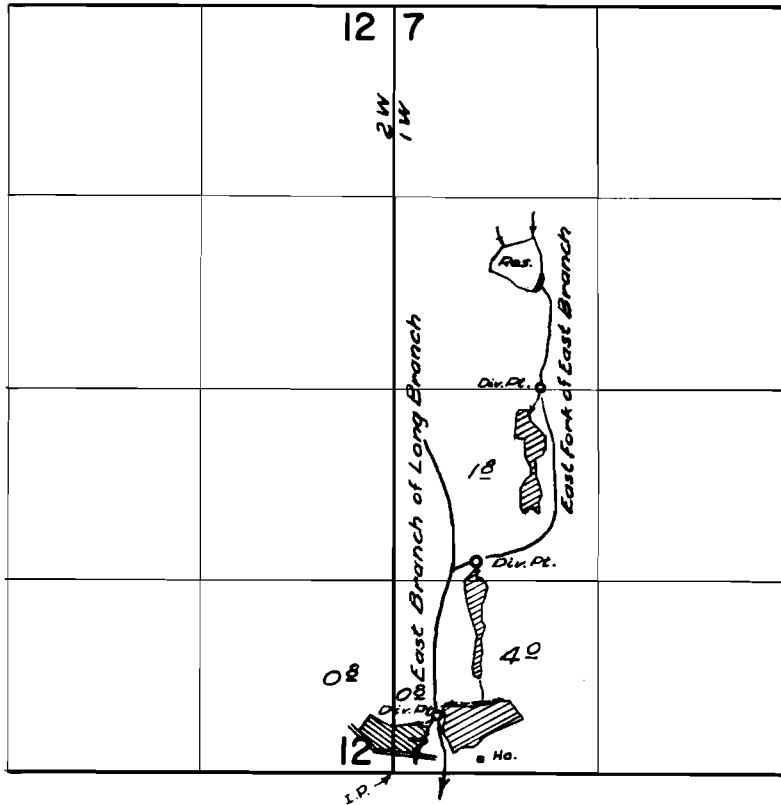

FINAL PROOF SURVEY UNDER

Application No. 22413 Permit No. 17705
R-22412 R.879
IN NAME OF

.....
Surveyed 14 APRIL 1960, by Mr. Bishop