


T 33 S R 6 W W M

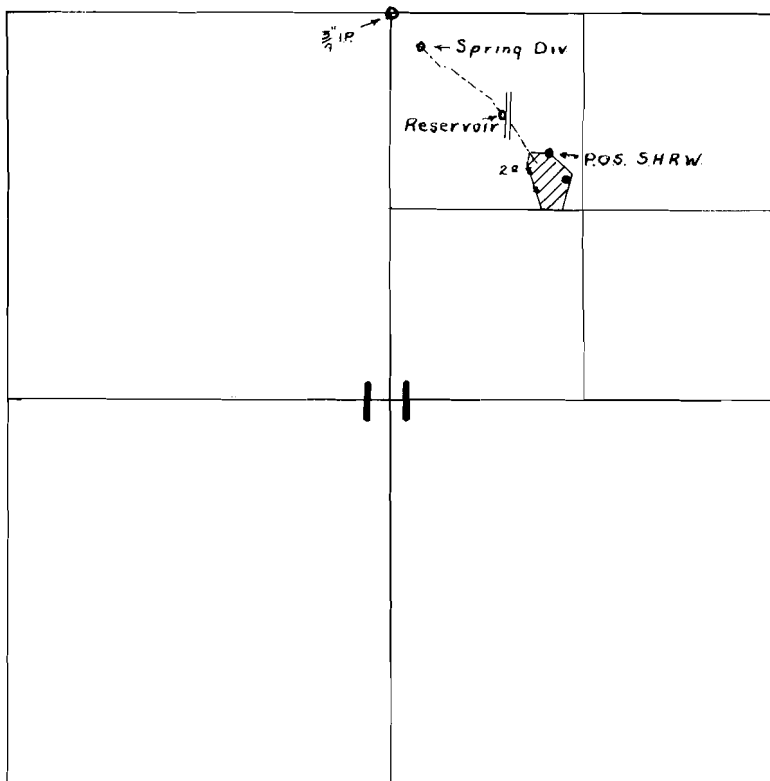

FINAL PROOF SURVEY
UNDER

Application No 30390 Permit No 23886

IN NAME OF
Joseph M Poe

Surveyed March 30 1961 by Steimer