


T.39S.R.3W.W.M.

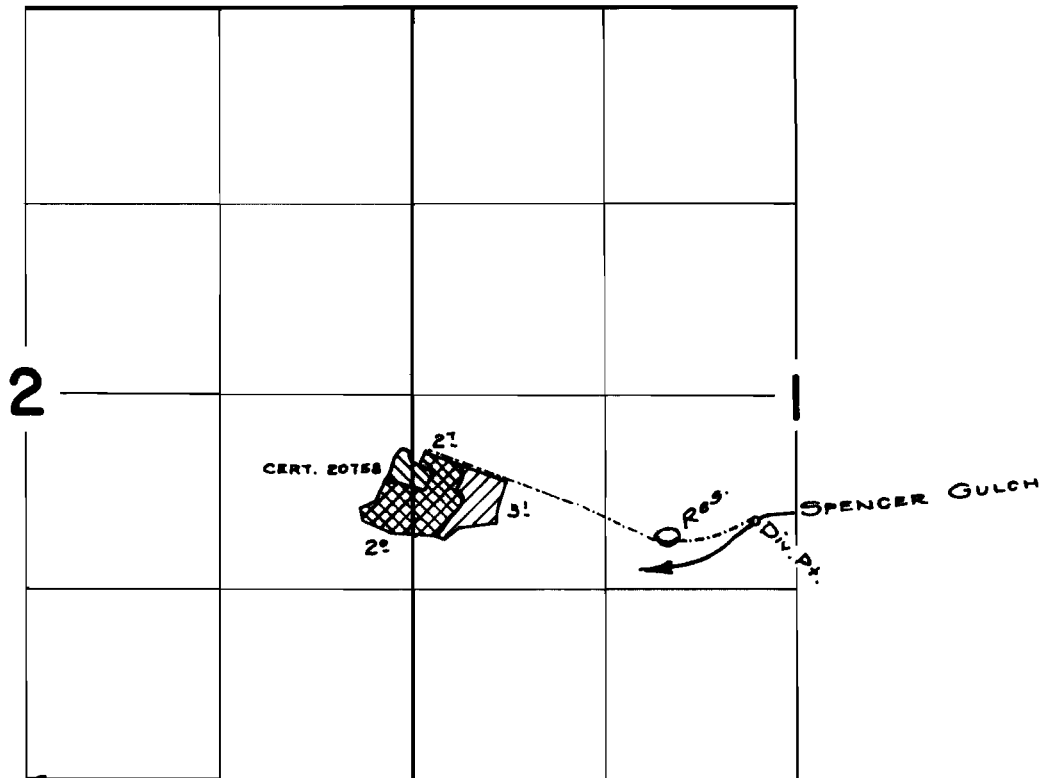

FINAL PROOF SURVEY
UNDER

Application No. 30040 Permit No. 23686
IN NAME OF

CHESTER R. PURSELL

Surveyed April...ll. 1961., by *R. Johnson*