


TOWNSHIP 28 S., RANGE 11 W.

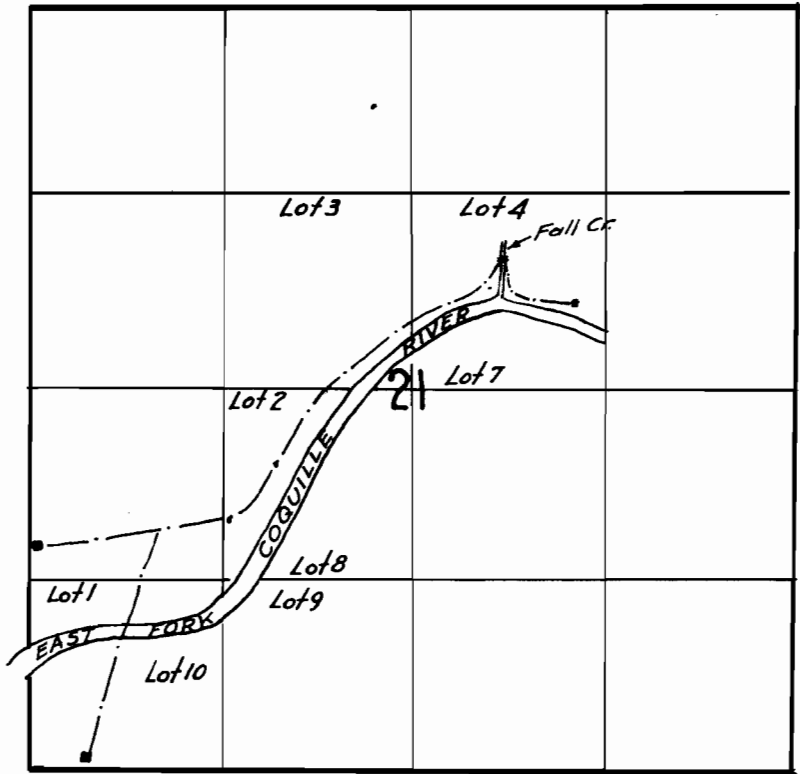

FINAL PROOF SURVEY

UNDER

Application No. 18145 Permit No. 13789

IN NAME OF

A. J. Mayse

Surveyed June 14. 10 41., by Ed Cummings