


T.15S.R.12W.W.M.

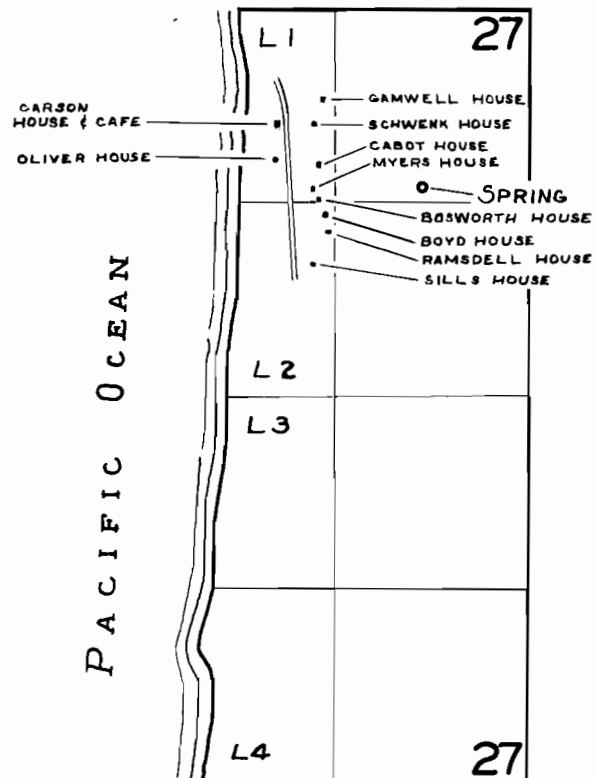

FINAL PROOF SURVEY
UNDER

Application No. 31598..... Permit No. 24924...
IN NAME OF

..... E. S. GAMWELL ET AL

Surveyed JUNE 9, 1961, by C. D. BARTELS...