


T.18S.R.2W.W.M.

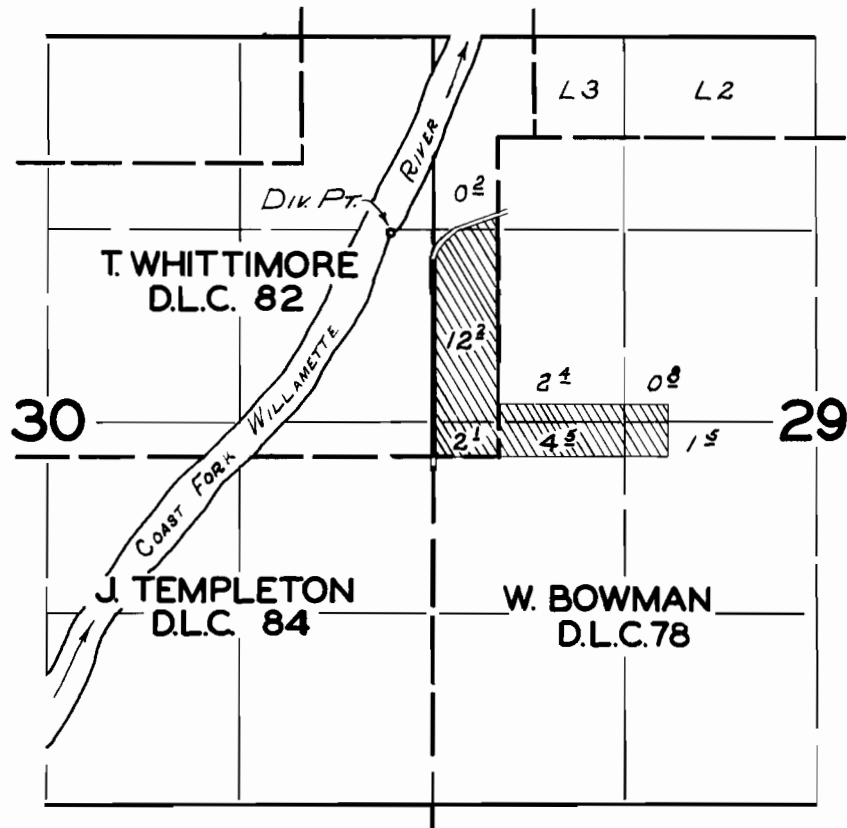

FINAL PROOF SURVEY
UNDER

Application No. 31667... Permit No. 25028
IN NAME OF

T.J. WILLEY

Surveyed *MAY 25 1961*, by *C.O. BARTELS*.....