


T.18S.R.2W.W.M.

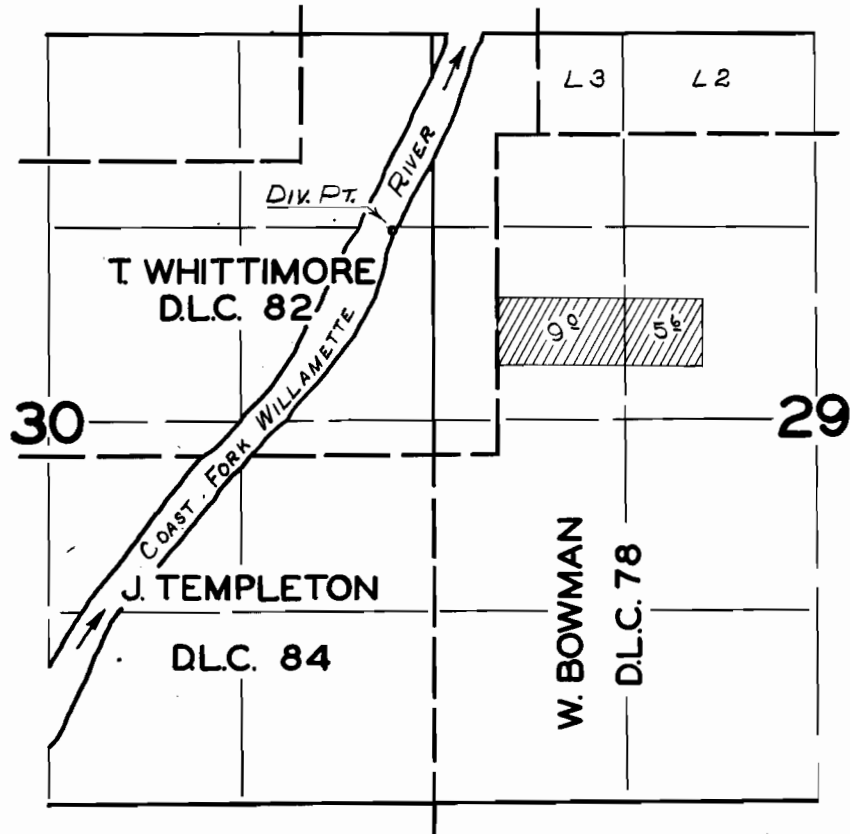

FINAL PROOF SURVEY
UNDER

Application No. 31668 Permit No. 25029
IN NAME OF

AMBROSE D. LONG

Surveyed MAY 25 1961, by C.O. BARTELS.