


T.15S.R.12W.W.M.

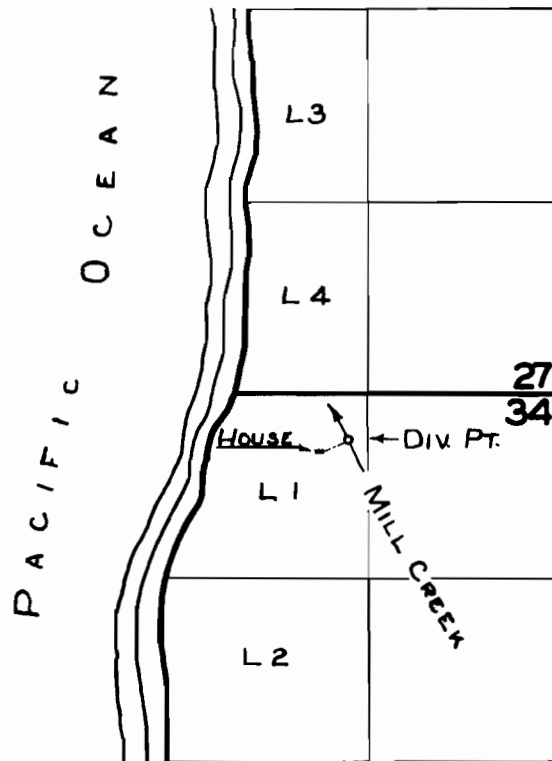

FINAL PROOF SURVEY
UNDER

Application No. 32042 Permit No. 25273
IN NAME OF

WILLIAM N. YOUNG

Surveyed JUNE 5 1961, by C. D. BARTELS