


T.17S.R.8W.W.M.

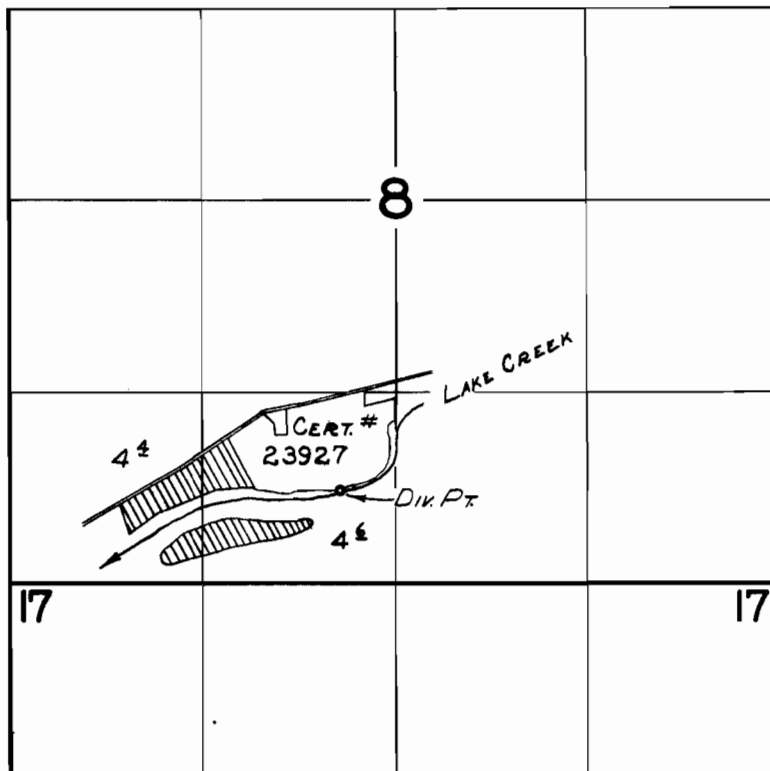

FINAL PROOF SURVEY
UNDER

Application No. 32037..... Permit No. 25288.....
IN NAME OF

..... *ADDISON W. SLACK*

Surveyed *MAY 9*..... 1961..... by *C.O. BARTELS*.....