


T.16S.R. 4E.W.M.

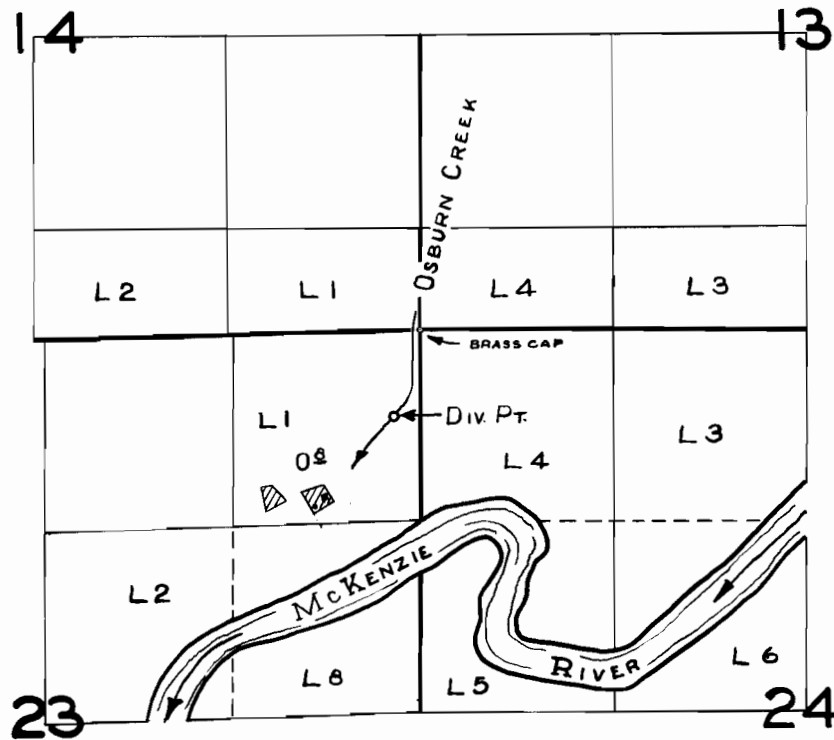

FINAL PROOF SURVEY UNDER

Application No. 32528. Permit No. 25694...
IN NAME OF

..... ROY D. & MERNA M. SEAL

Surveyed JULY 11, 1961, by C.O. BARTELS...