


T.19S.R.12W.W.M.

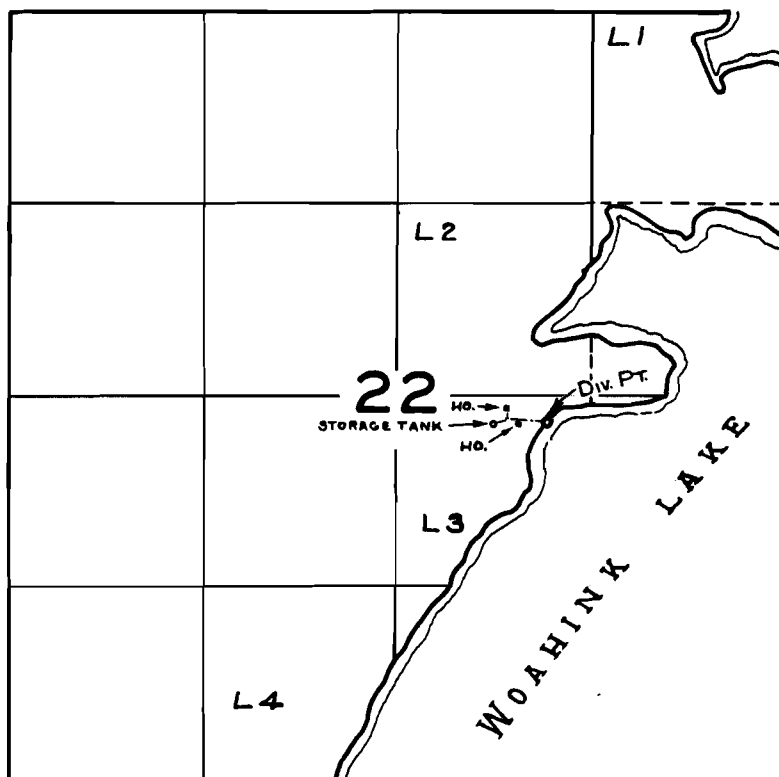

FINAL PROOF SURVEY
UNDER

Application No. 32549..... Permit No. 25703....
IN NAME OF

.....JAMES W. FORD.....

Surveyed JUNE 8..... 1961., by C.O. BARTELS.