


T.16S.R.2E.W.M.

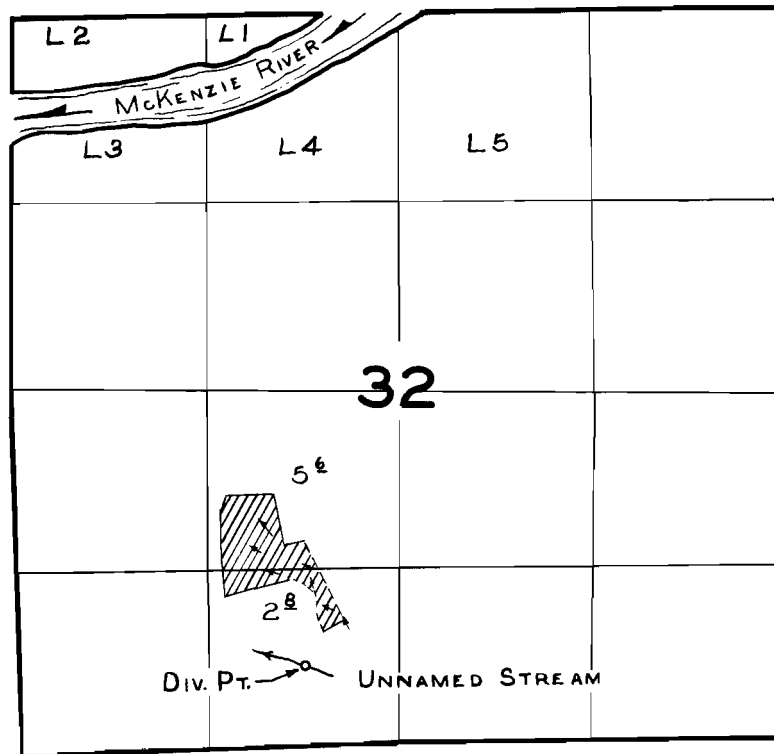

FINAL PROOF SURVEY
UNDER

Application No. 32.638... Permit No. 25.744...
IN NAME OF

.....EUGENE V. & MARJORIE P. NORRIS.....

Surveyed JULY 13 1961., by C.D. BARTELS.....