


T.15S. R. 5 W.W.M.

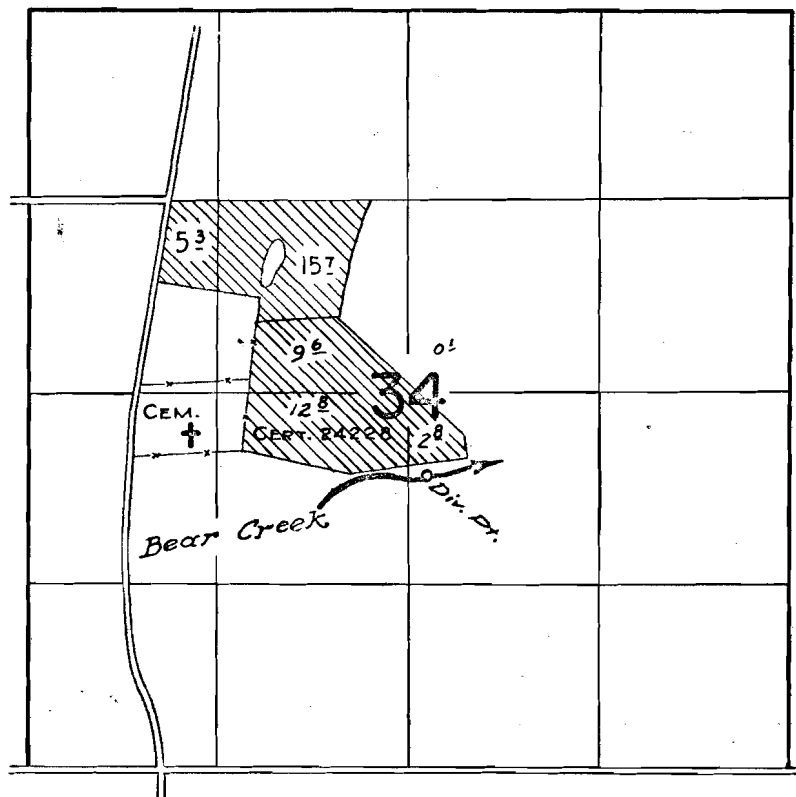

Application No. 44621
Permit No. 33385

FINAL PROOF SURVEY
UNDER

Application No. ~~32658~~ Permit No. ~~25754~~
IN NAME OF

ROBERT P. DOERR

Surveyed May 22 1961, by *L. Jackson*