


T.18S.R.2W.W.M.

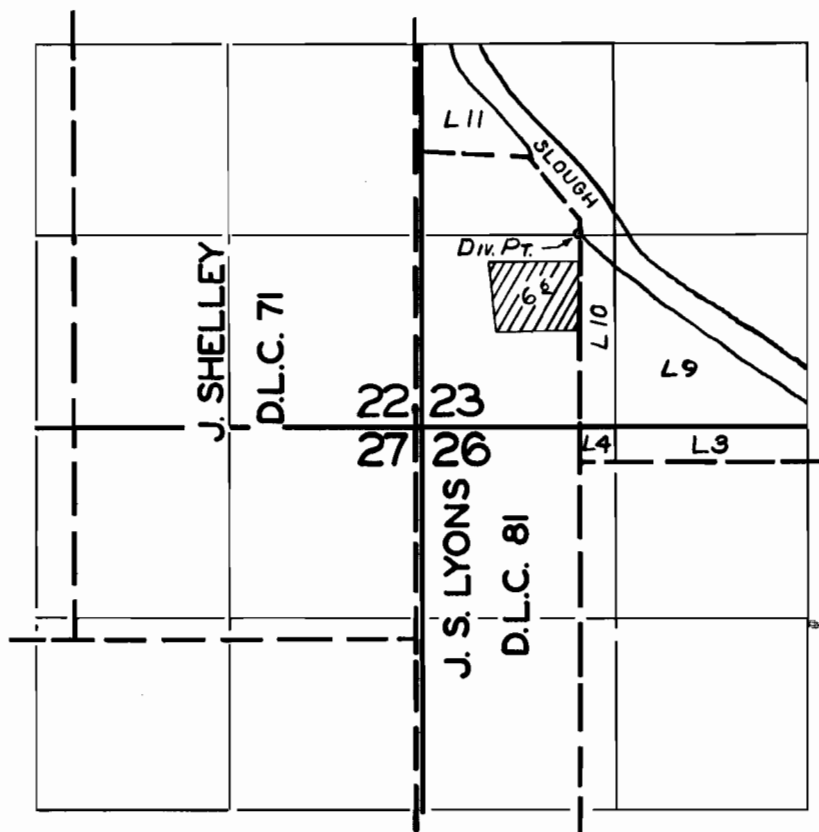

FINAL PROOF SURVEY
UNDER

Application No. 32823.... Permit No. 25906.....
IN NAME OF

.....*ARLIE R. & MYRNA TURNER*.....

Surveyed *JULY 20 1961*, by *C.D. BARTELS*...