


T.18S.R. 3W.W.M.

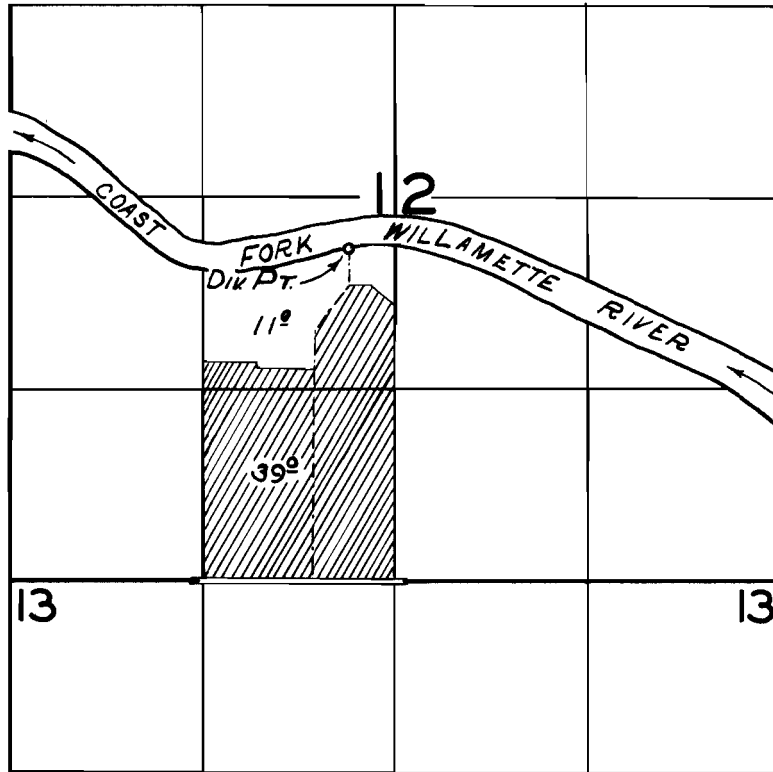

FINAL PROOF SURVEY
UNDER

Application No. 32826..... Permit No. 25907.....
IN NAME OF

..... *NORMAN R. EVONUK*

Surveyed *MAY 11*..... 1961., by *C.O. BARTELS*.....