


T.19S.R.1W.W.M.

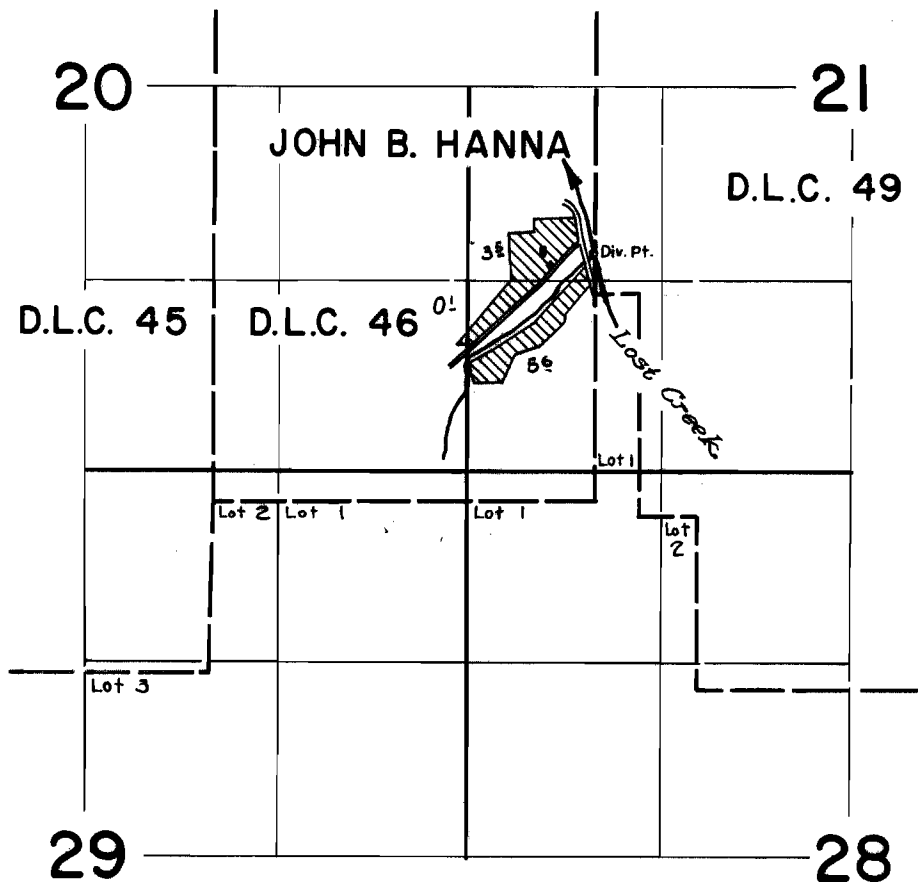

FINAL PROOF SURVEY
UNDER

Application No. **32932**... Permit No. **26025**...
IN NAME OF

A. F. HARRSCH

Surveyed May 23 1961., by *L. H. Jackson*