


T.18S.R.3W.W.M.

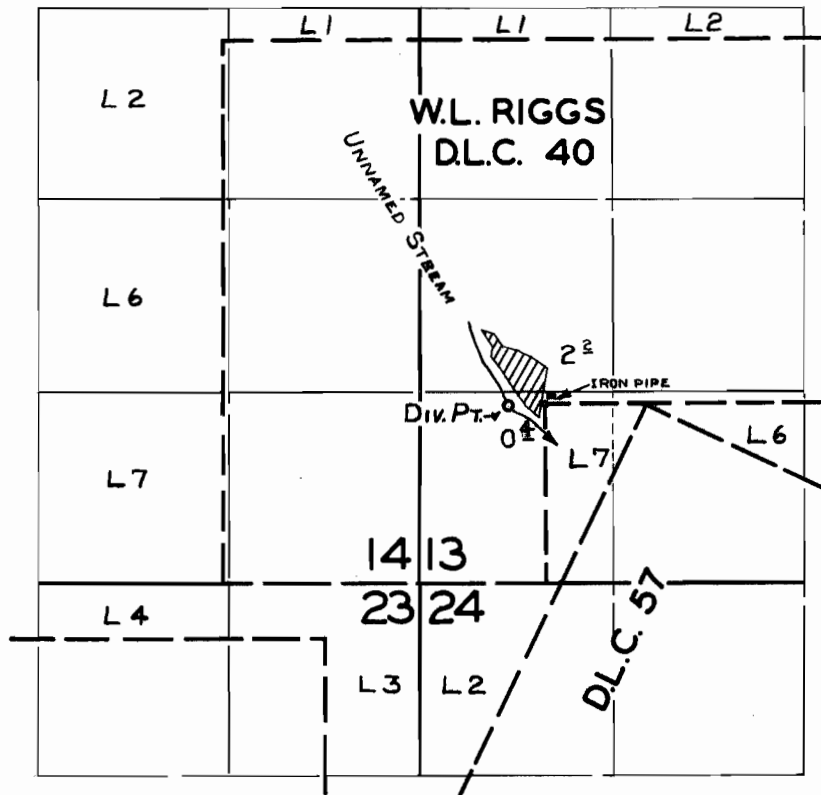

FINAL PROOF SURVEY UNDER

Application No. 33043 Permit No. 26185
IN NAME OF

.....WILLIAM N. MILLS.....

Surveyed JULY 20, 1961, by C. Q. BARTELS