


T.16S.R. 4E.W.M.

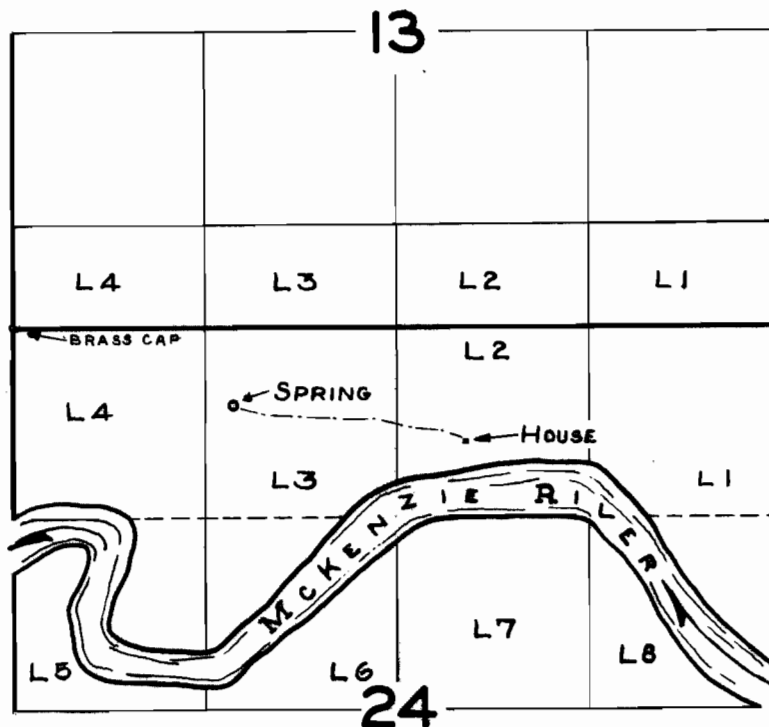

FINAL PROOF SURVEY
UNDER

Application No. 33134... Permit No. 26203...
IN NAME OF

.....*MR. & MRS. EMMET F. RYORDAN*.....

Surveyed *JULY 10 & 11 1961*, by *C. D. BARTELS*