


T.17S.R.2W.W.M.

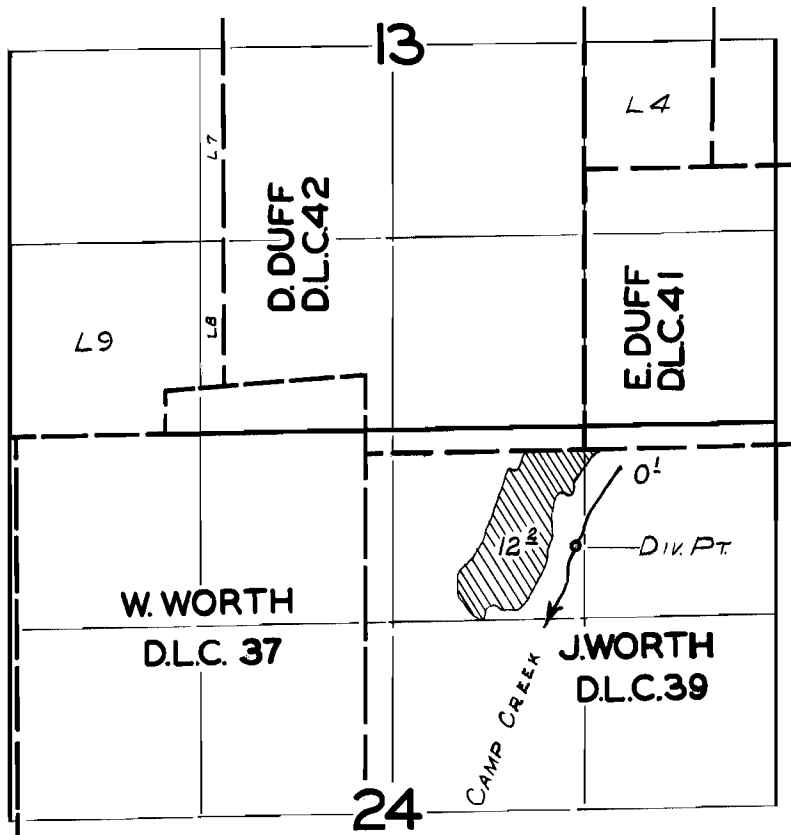

**FINAL PROOF SURVEY**  
UNDER

Application No. 33258 ... Permit No. 26295...  
IN NAME OF

.....*JOHN BERGMA*.....

Surveyed *MAY 24 1961*, by *C. O. BARTELS*.....