


T.18S.R.2W.W.M.

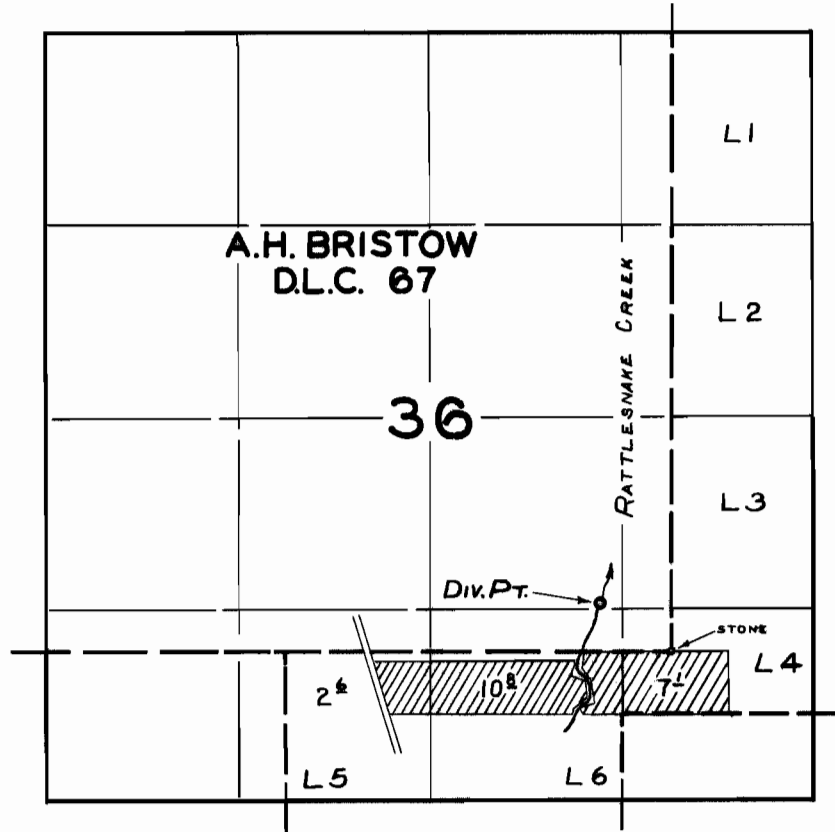

FINAL PROOF SURVEY
UNDER

Application No. 33356... Permit No. 26373...
IN NAME OF

.....PAUL D. GREEN.....

Surveyed MAY 25, 1961, by C. O. BARTELS.