


T. 23 S. R. 3 W. W. M.

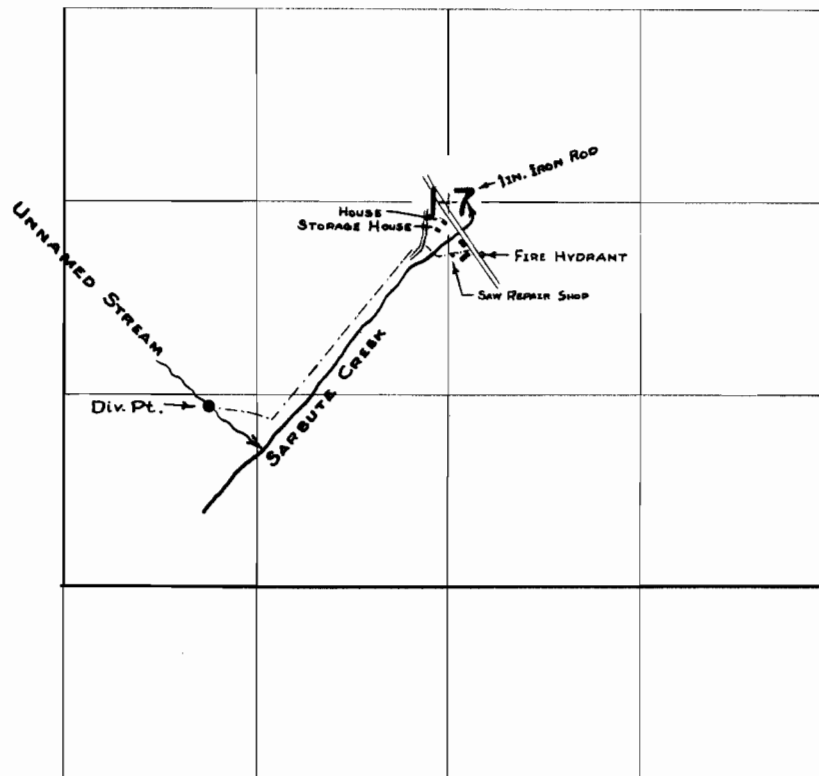

NOTE : Div. Pt. & Stream Location Traced From Applicants Map

**FINAL PROOF SURVEY
UNDER**

Application No. 33950 Permit No. 26763.
IN NAME OF

WEYERHAEUSER COMPANY

Surveyed 23 May 1961, by *M. Bish*