


T. 15 S. R. 47 E. W. M.

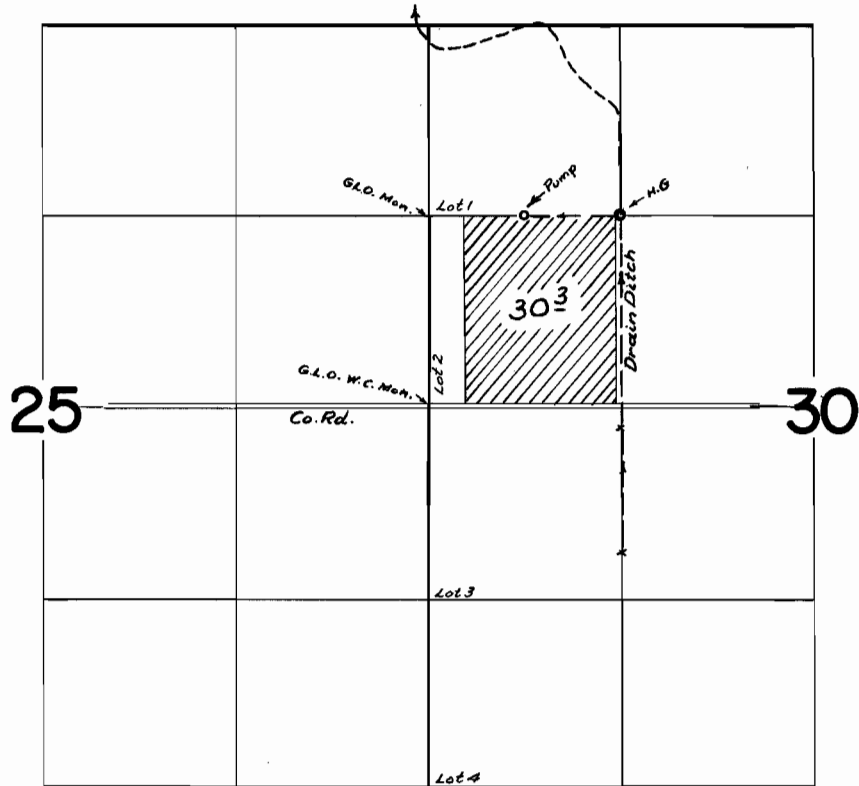

**FINAL PROOF SURVEY**  
UNDER

Application No. 29405 Permit No. 23240  
IN NAME OF

H. T. CARLSON

Surveyed 28 Oct. 1960, by m. Bish