


T.5S.R.182W.W.M.

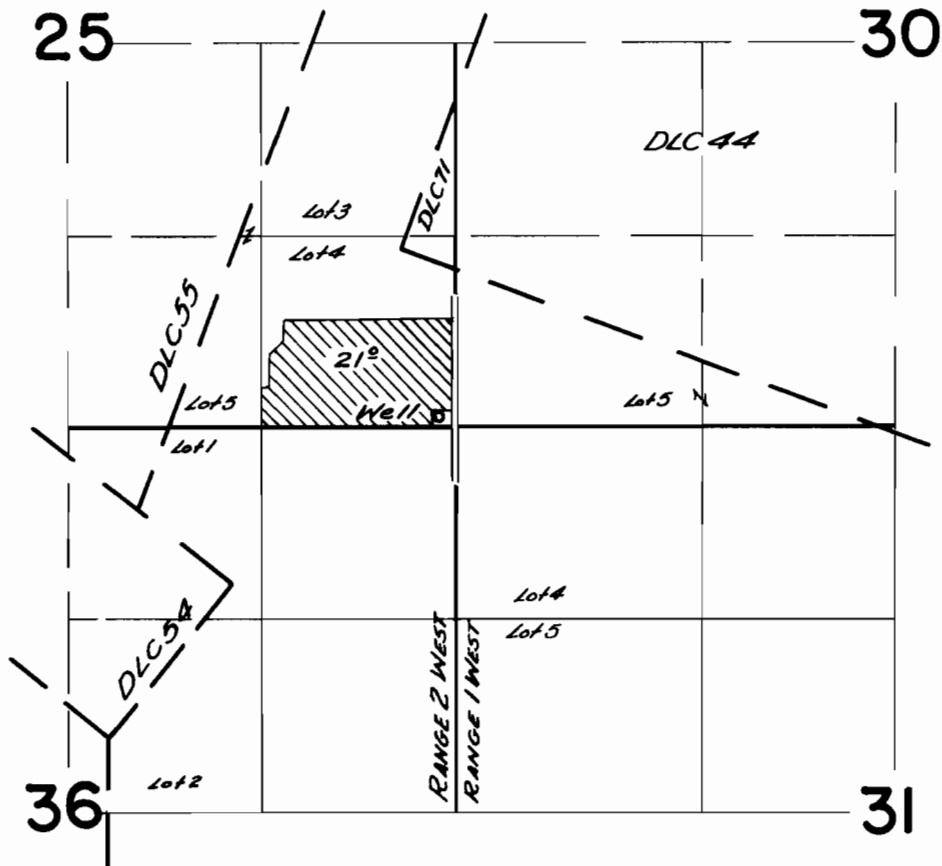

**FINAL PROOF SURVEY
UNDER**

Application No. G-502 Permit No. G-359
IN NAME OF

ALICE STRAYENS

Surveyed April 4 1961, by C.O. Daulton