


T. 6 S. R. I. W. W. M.

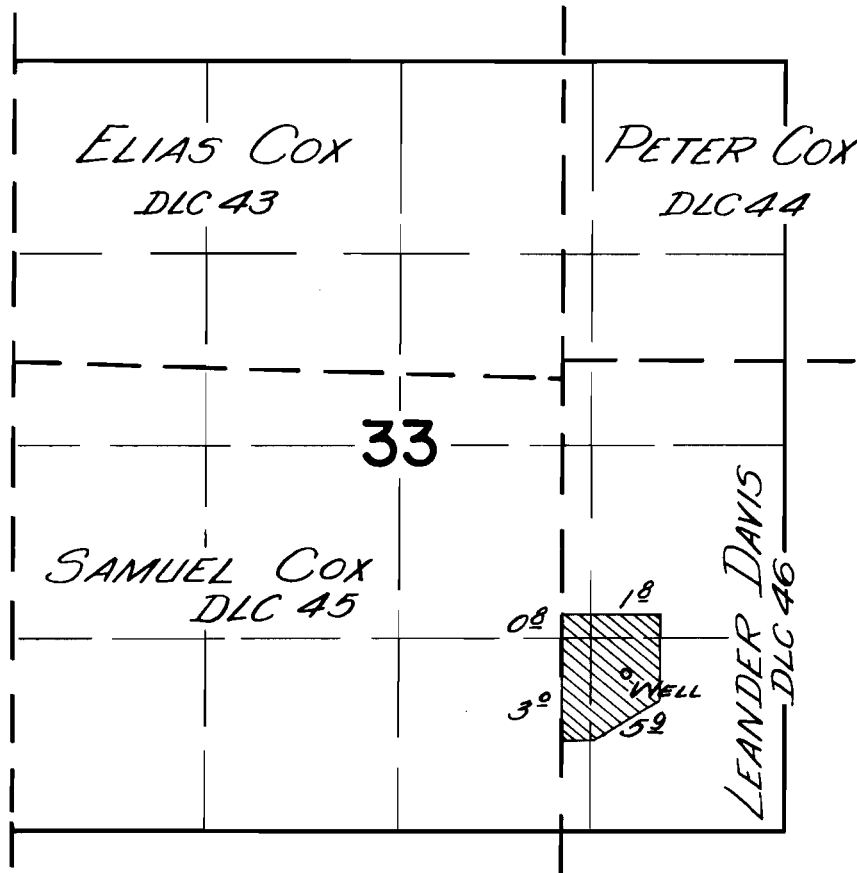

FINAL PROOF SURVEY UNDER

Application No. *G-756* Permit No. *G-654*
IN NAME OF

OSCAR STRAND

Surveyed *April 28 1961*, by *C. O. Bartolo*