


T. 9 S. R. 2 W. W. M.

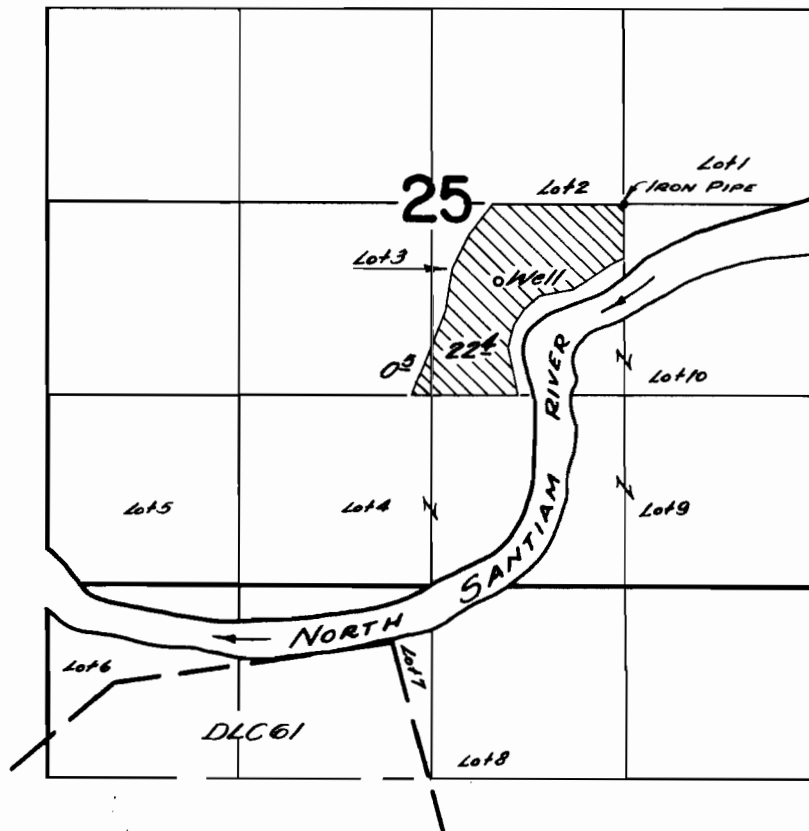

**FINAL PROOF SURVEY**  
UNDER

Application No. G-824 Permit No. G-716  
IN NAME OF

LOUIS SCOFIELD

Surveyed APRIL 6, 1961, by C. O. Bartlett