


T.4S.R.1W.W.M.

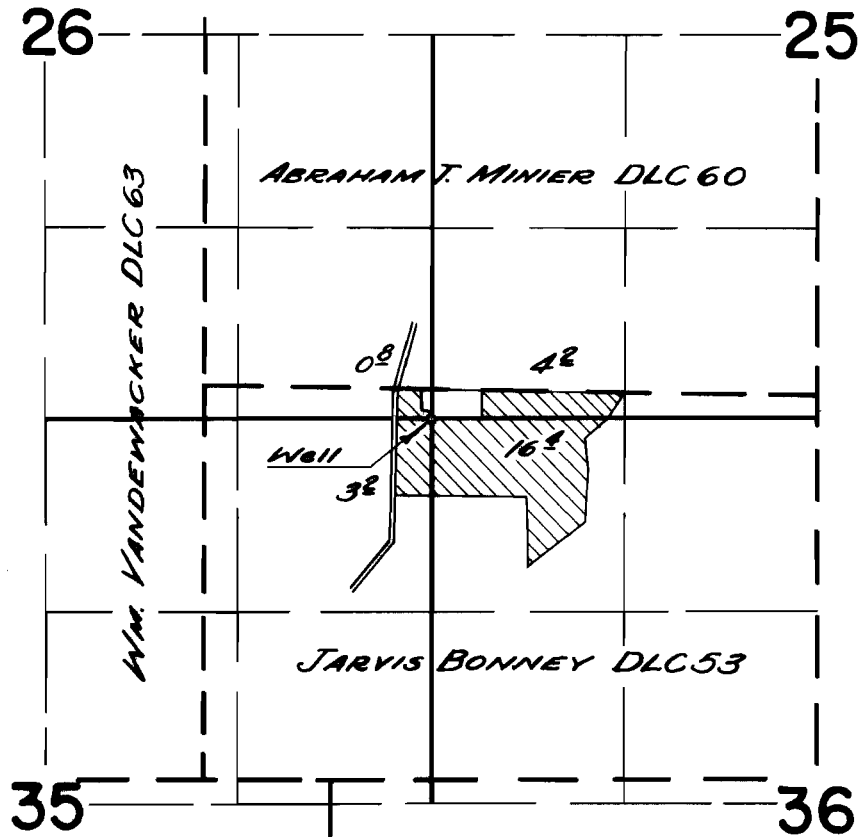

FINAL PROOF SURVEY
UNDER

Application No. *G-992* Permit No. *G-875*
IN NAME OF

RICHARD MOOREHOUSE

Surveyed *APRIL 5, 1961*, by *C.O. Bartels*