


T. 9S. R. 3W. W.M.

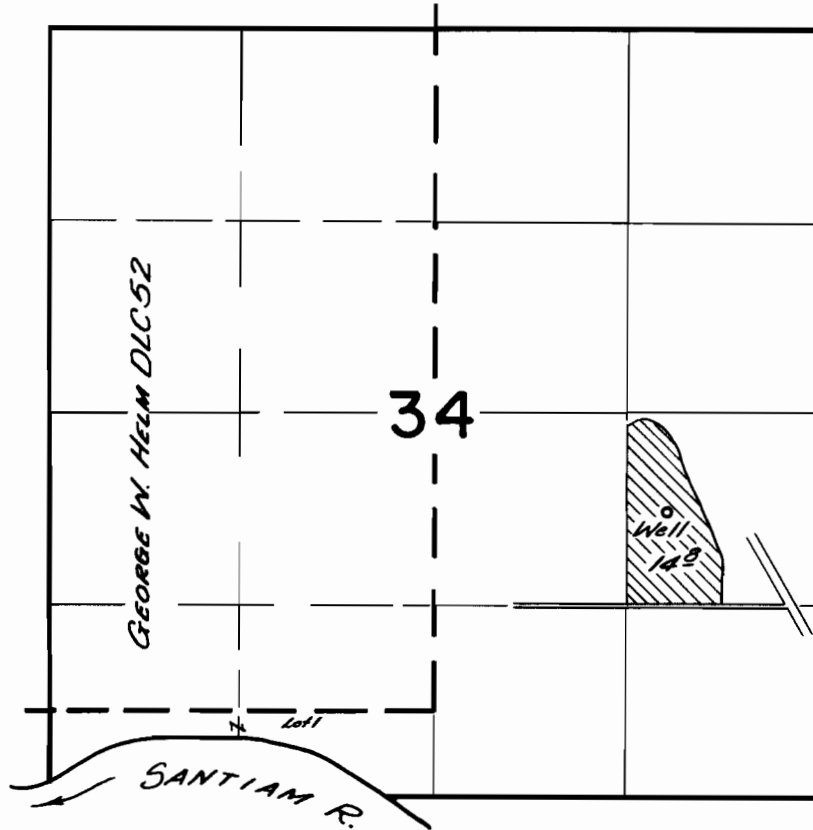

FINAL PROOF SURVEY
UNDER

Application No. *G-996* Permit No. *G-894*
IN NAME OF

ROBERT F. RICKARD

Surveyed *April 7* 19*61*, by *C. D. Bartels*