


# T. 4S. R. 1W. W.M.

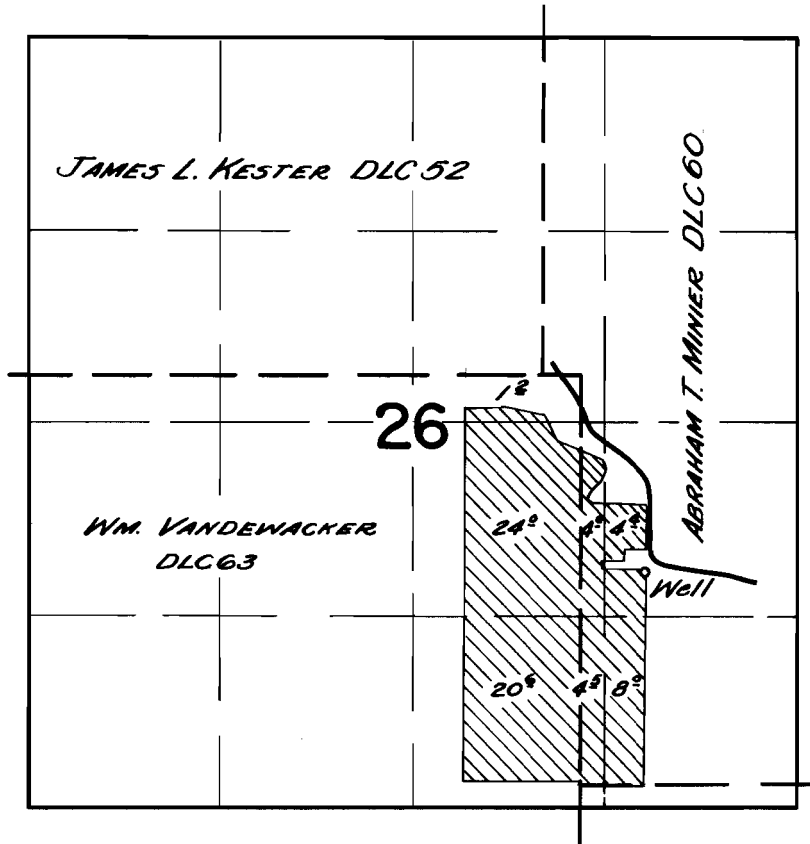

## FINAL PROOF SURVEY UNDER

Application No. *G-1310* Permit No. *G-1170*  
IN NAME OF

*BILL & FRANK FOBERT*

Surveyed *April 4* 1961, by *C. O. Bartels*