


T.4S. R.1W. W.M.

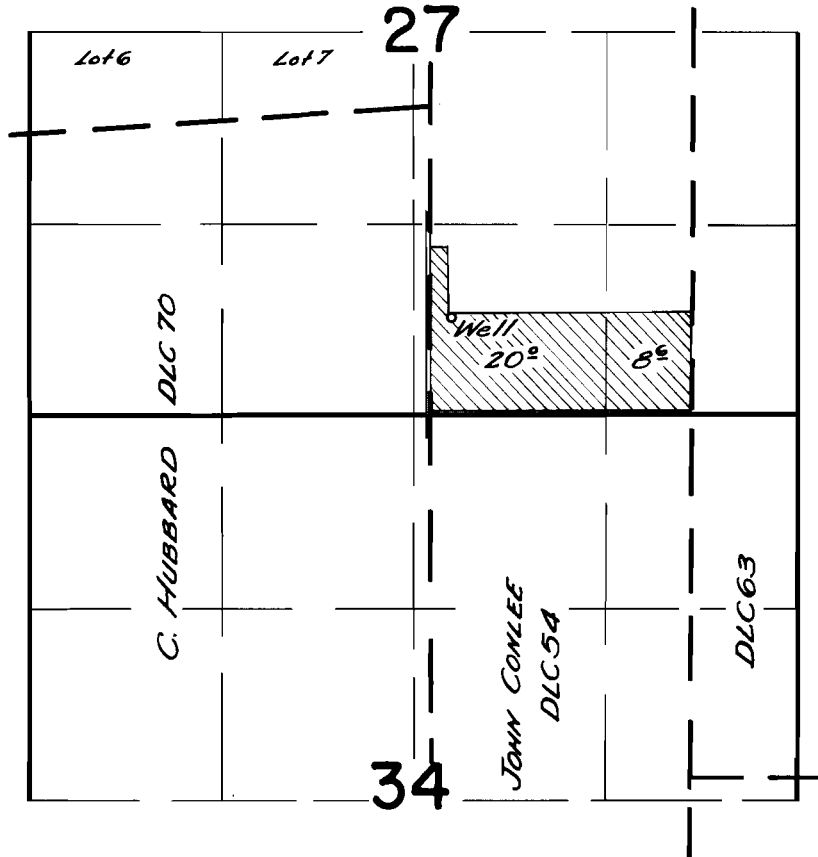

FINAL PROOF SURVEY
UNDER

Application No. *G-1626* Permit No. *G-1499*
IN NAME OF

ALBERT DEMPSEY

Surveyed *April 4* 1961, by *Collaata*