


T. 9810S. R. 3W. W.M.

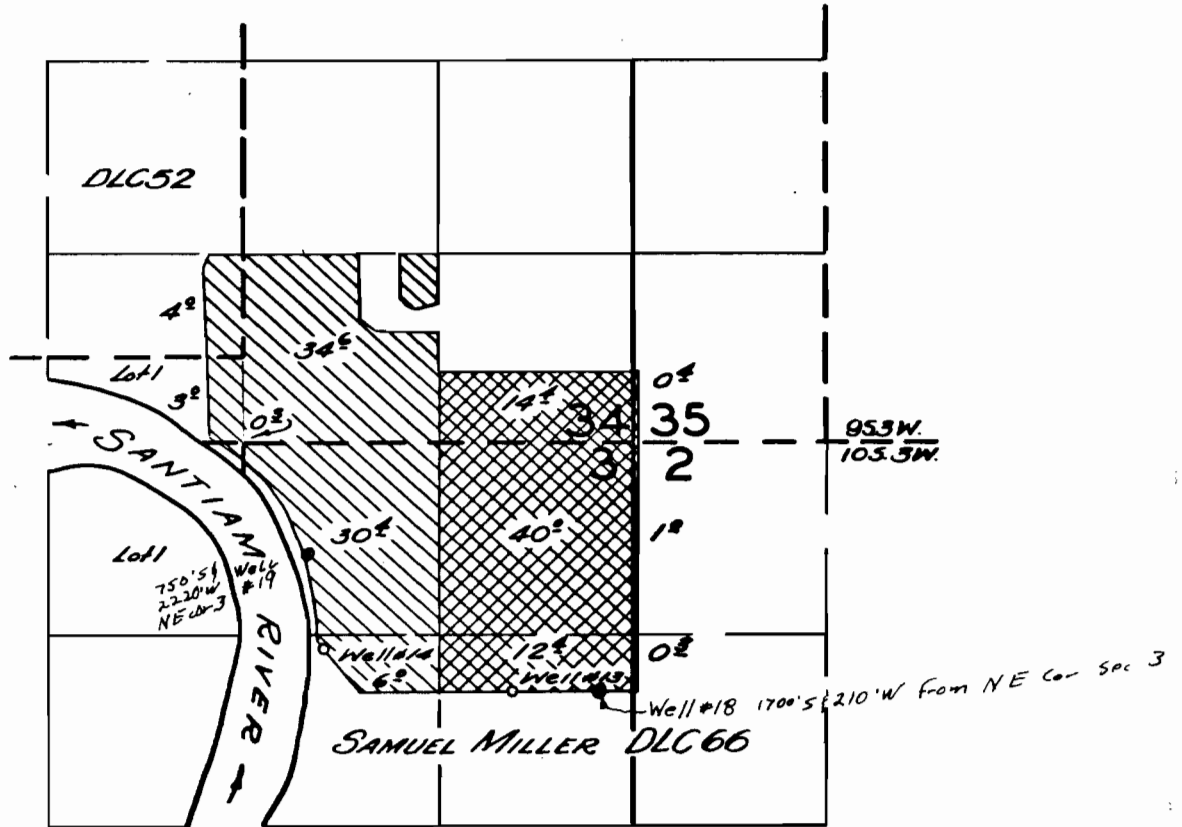

Application No. G-4712
 Permit No. G-4436

FINAL PROOF SURVEY
 UNDER

Application No. G-1693 Permit No. G-1553
G-1694 G-1554

IN NAME OF

DALE L. TURNIDGE

Surveyed April 7, 1961, by C. B. Smith