


T. 7 S. R. 1 W. W. M.

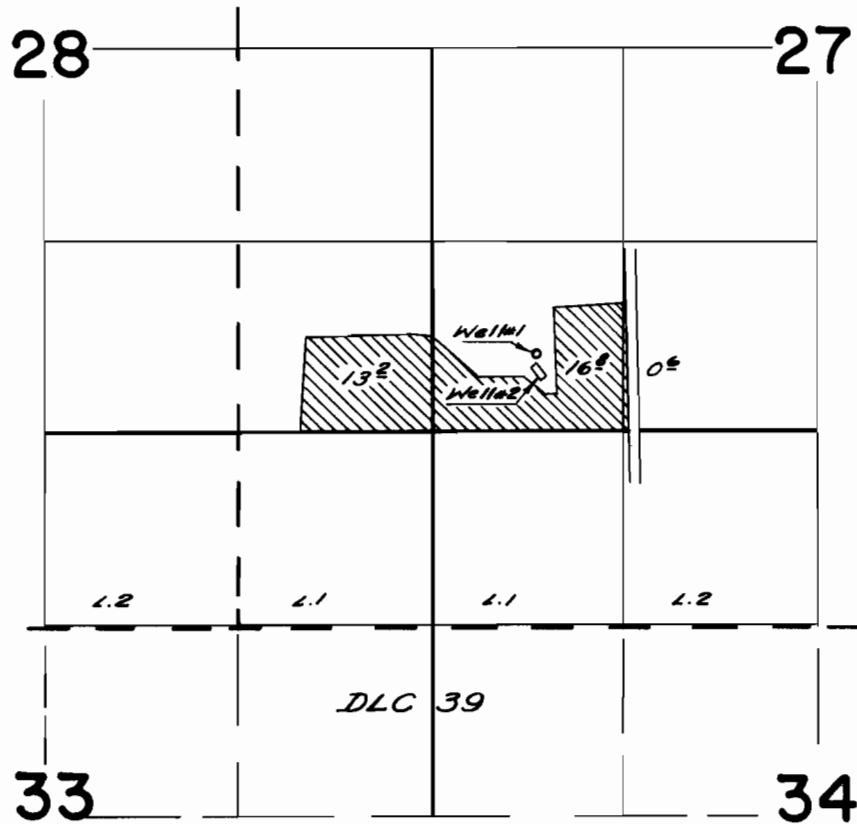

FINAL PROOF SURVEY UNDER

Application No. *G-1802* Permit No. *G-1648*
IN NAME OF

.....*KEITH G. JOHNSON*.....

Surveyed *MARCH 30, 1961*, by *C. Bartels*.....