


T.5S. R.3W.W.M.

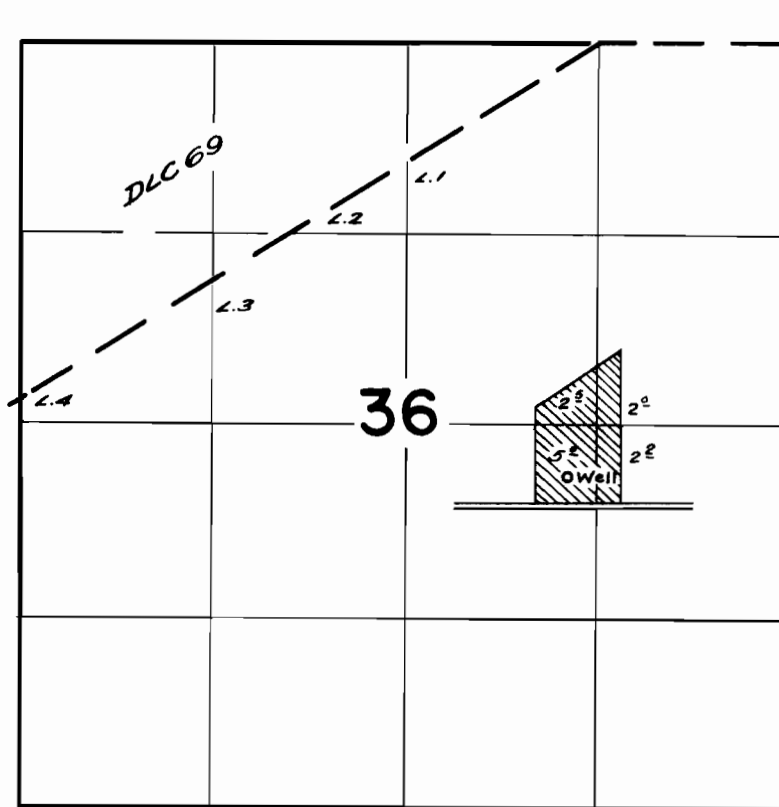

FINAL PROOF SURVEY UNDER

Application No. *G-1835* Permit No. *G-1680*
IN NAME OF

EDWARD & BESSIE JAENICKE

Surveyed *April 3*, 1961, by *W. Bartlett*