


T.8S. R.3W.W.M.

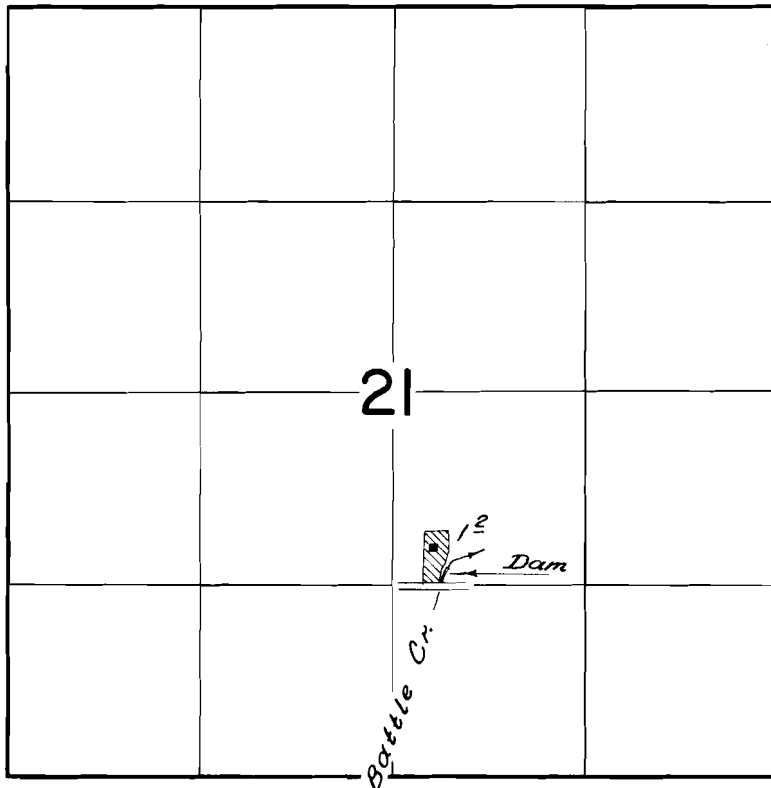

FINAL PROOF SURVEY
UNDER

R-25865 R-1165
Application No. 25866 Permit No. 20310
IN NAME OF

L. C. FREDRICKSON

Surveyed *MARCH 20 1961*, by *C. O. Bartels*