


T.6S.R.IW.W.M.

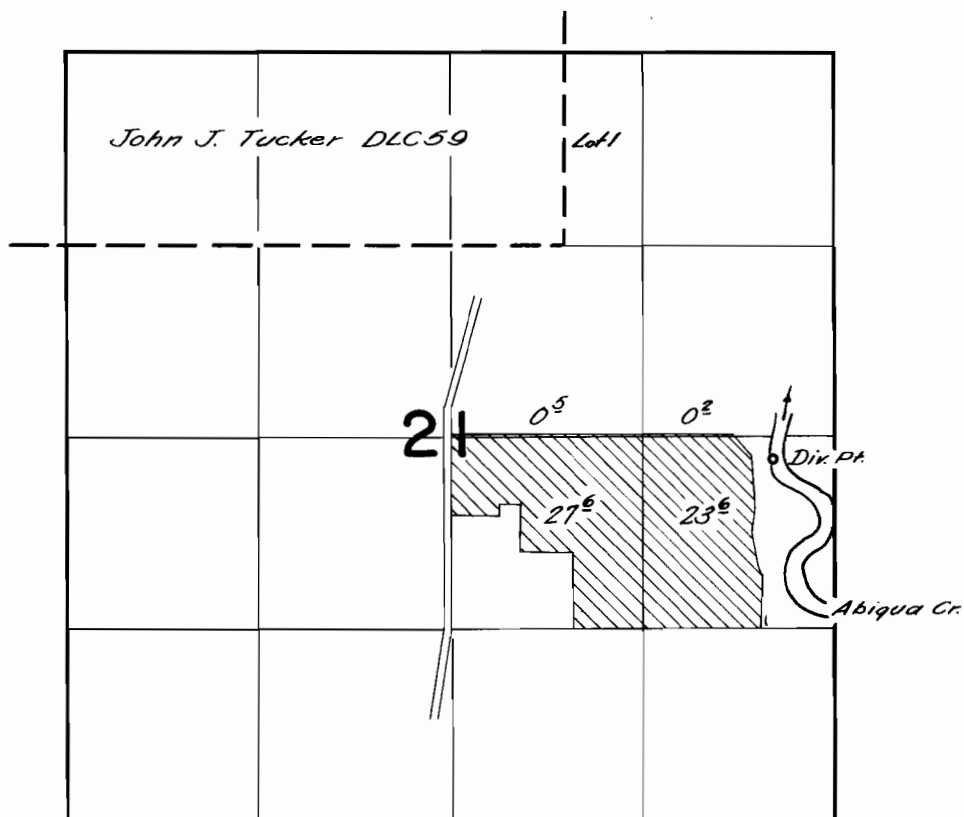

FINAL PROOF SURVEY UNDER

Application No. 30614... Permit No. 24119...
IN NAME OF

..... *KEITH ALTON NELSON*

Surveyed *April 26 1961*, by *C. B. Baitte*