


T. 6 S. R. 1 W. W. M.

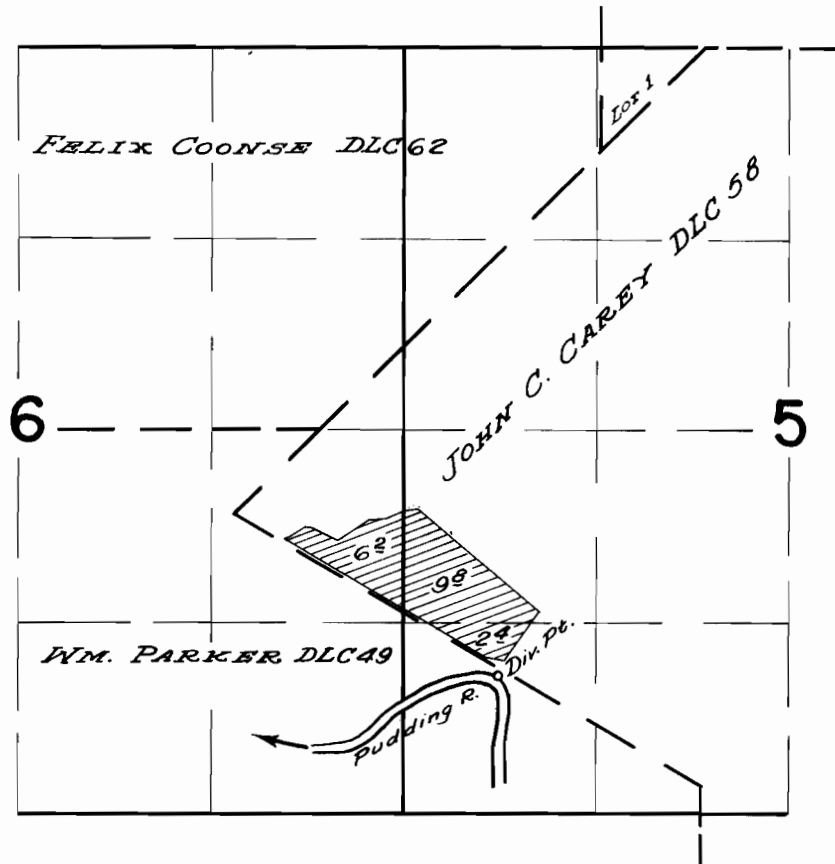

FINAL PROOF SURVEY UNDER

Application No. 31388 Permit No. 24832
IN NAME OF

ESTATE OF LEROY A. ESSON

Surveyed MAR. 29 1961, by C. O. Bartels