


T. 7S. R. 1W.W.M.

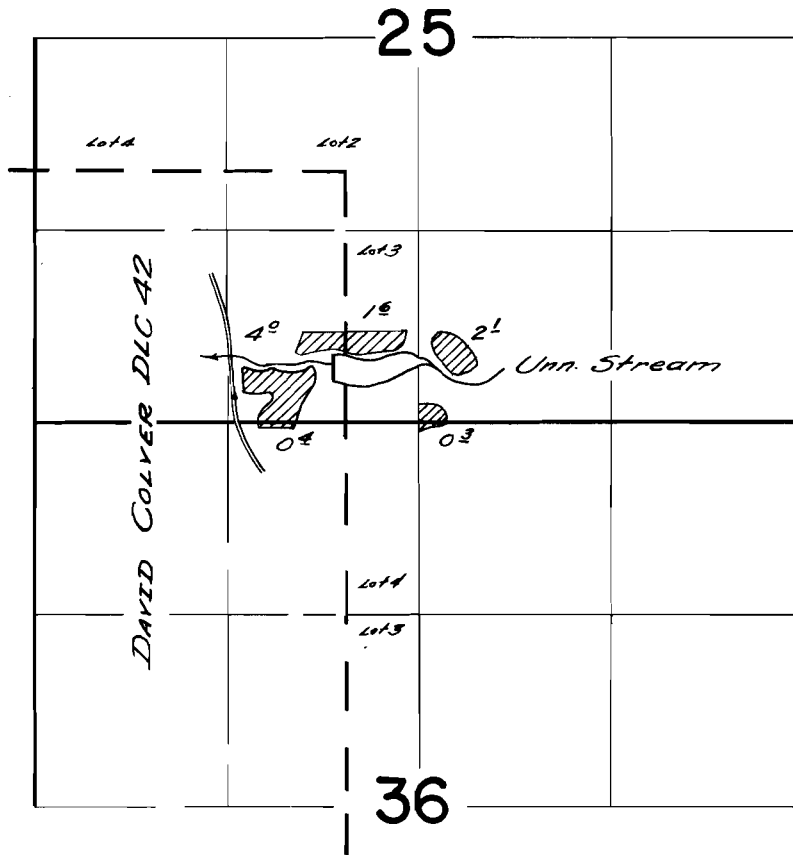

FINAL PROOF SURVEY
UNDER

Application No. R-31711 31712 Permit No. R-2043 25002
IN NAME OF

ARTHUR QAULEY

Surveyed MARCH 30 1961 by C. Bartels