


# T. 3S. R. 1W. W.M.

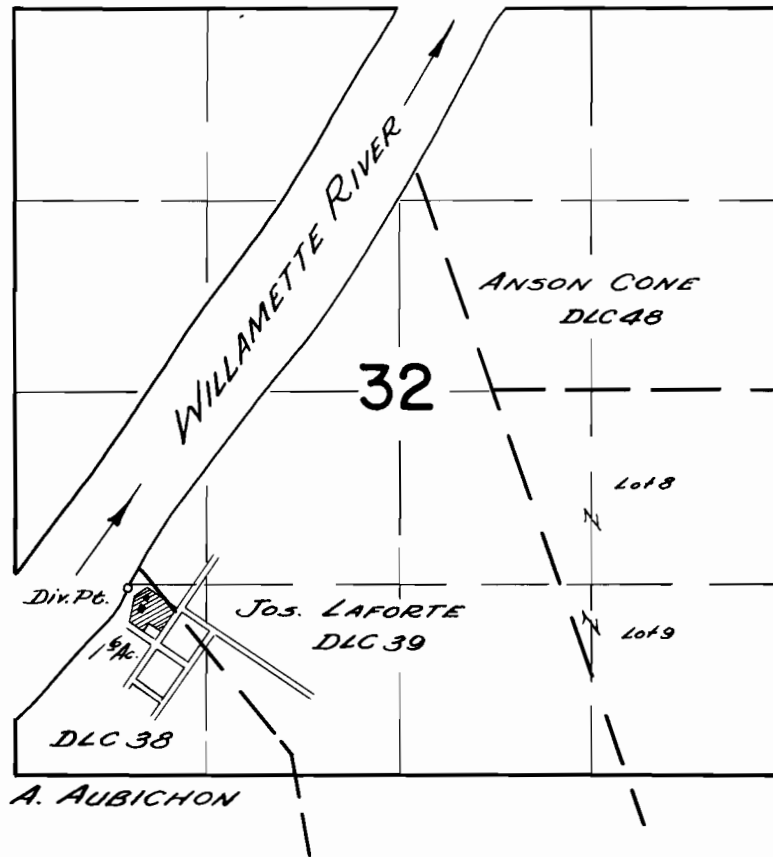

## FINAL PROOF SURVEY UNDER

Application No. 32462 Permit No. 25766  
IN NAME OF

RALPH G. SIMPSON

Surveyed April 5 1961, by C.O. Bartels