


T.10S. R.3W.W.M.

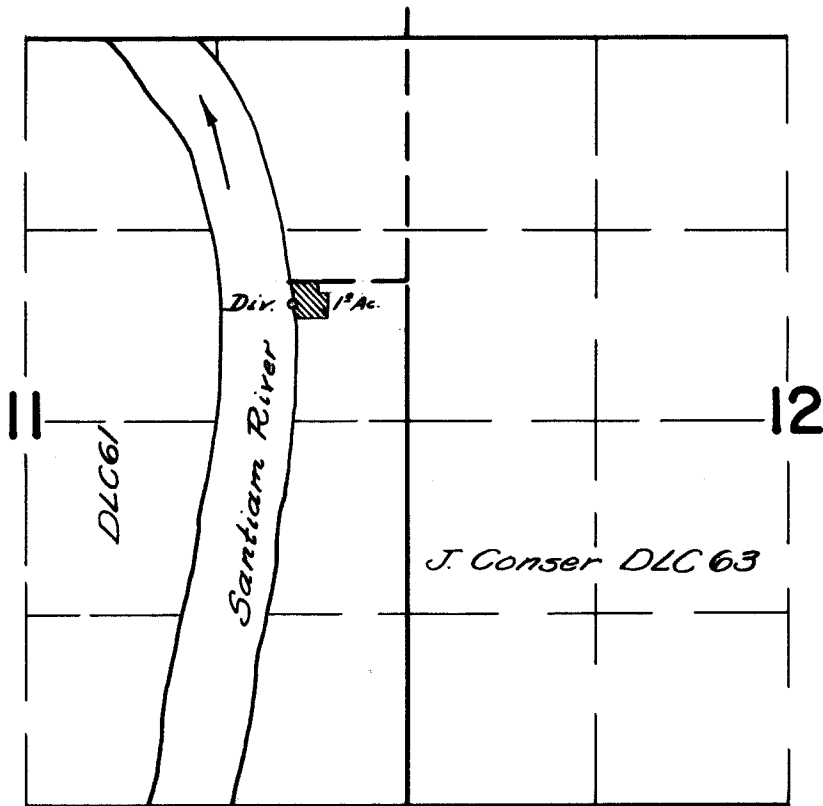

FINAL PROOF SURVEY
UNDER

Application No. *32239* Permit No. *25823*
IN NAME OF

.....*ROBERT R. BROWN*.....

Surveyed *APRIL 7, 1961*, by *C. B. Smith*.....