


T.6S.R.IW.W.M.

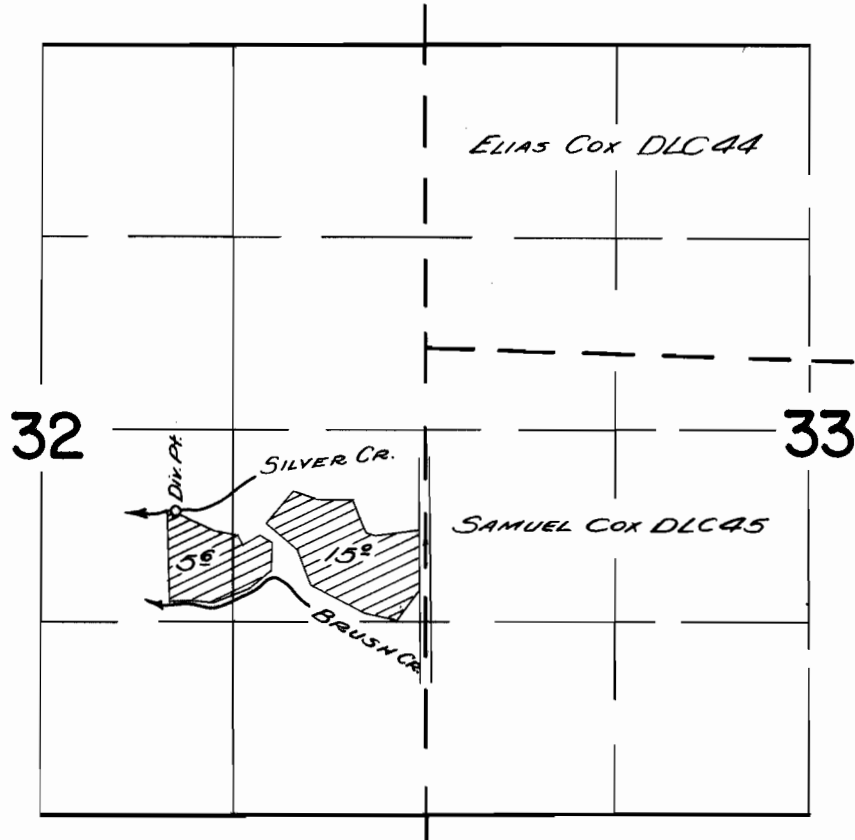

FINAL PROOF SURVEY
UNDER

Application No. 33190 Permit No. 26248
IN NAME OF

E. R. O. L. W. ROSS

Surveyed MARCH 29 1961, by C. O. Bartels