


T.5S. R.3W.W.M.

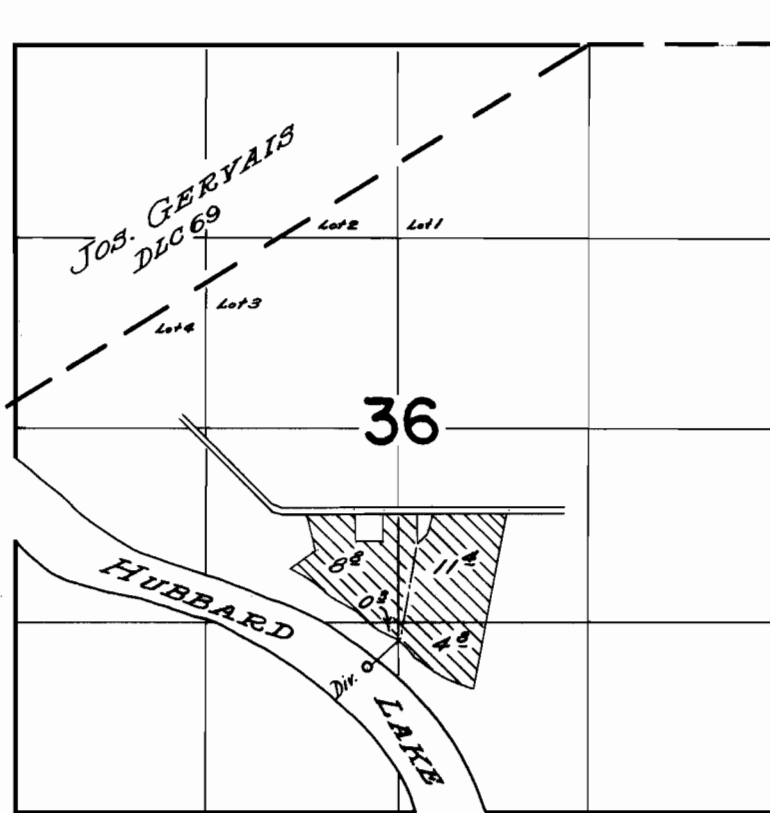

**FINAL PROOF SURVEY**  
UNDER

Application No. 33429 Permit No. 26428  
IN NAME OF

DONALD GUBSER

Surveyed APRIL 3 1961, by C. Bartlett