


T. 8S. R. 2W. W.M.

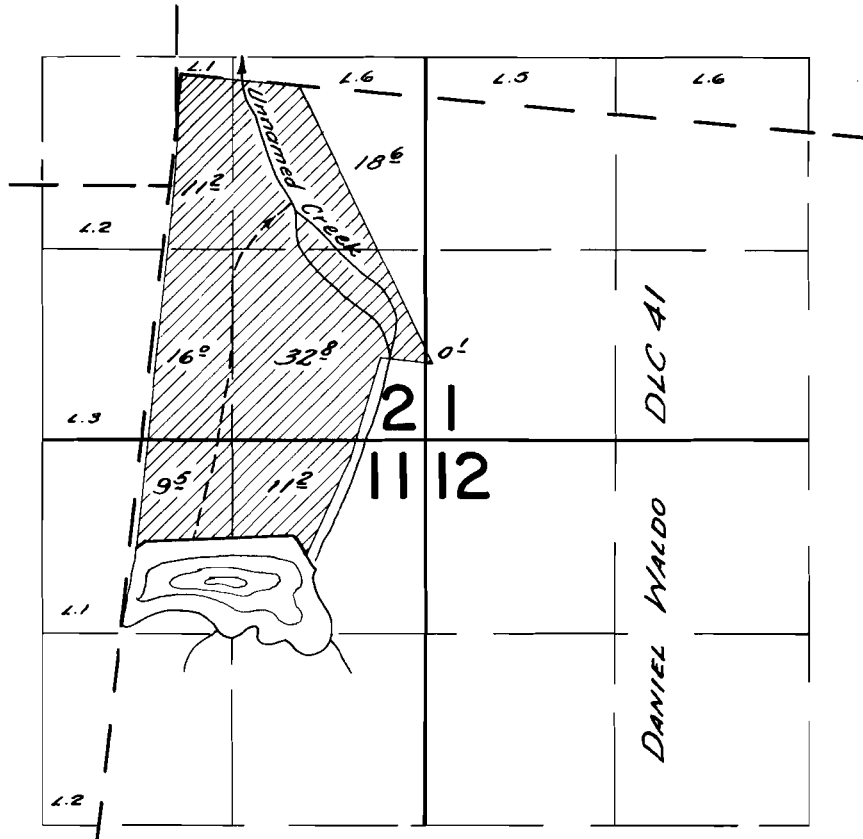

FINAL PROOF SURVEY UNDER

Application No. ^{R-33422} ~~33434~~ Permit No. ^{R-2299} ~~26454~~
IN NAME OF

LLOYD M. HILL, INC.

Surveyed March 24 1961, by C.O. Bartolo