


T6S.R.IW.W.M.

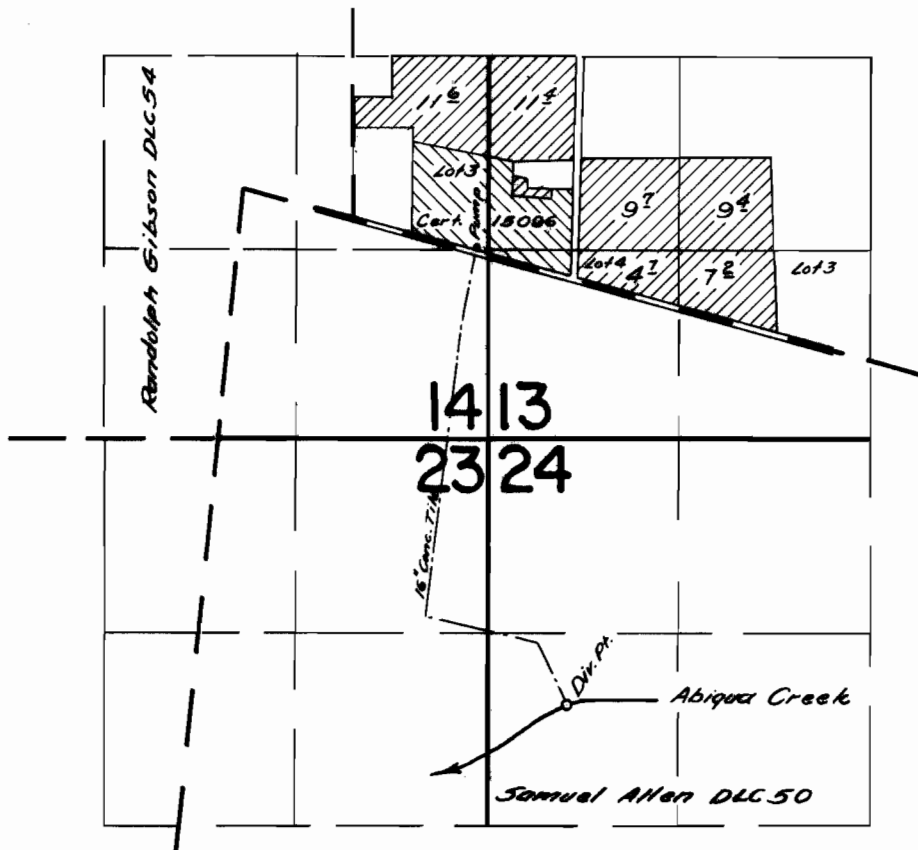

FINAL PROOF SURVEY UNDER

Application No. 33495 Permit No. 26476
IN NAME OF

MARIO RAVA

Surveyed March 29 1961, by C. Baetbo