


T.9S.R.IW.W.M.

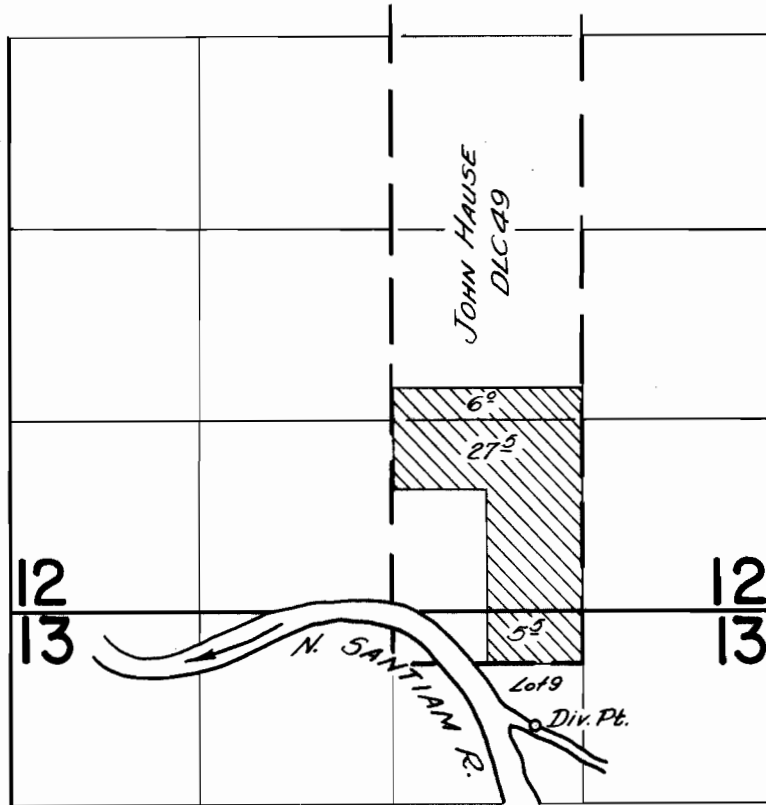

FINAL PROOF SURVEY
UNDER

Application No. 33692... Permit No. 26633...
IN NAME OF

JOE A. & PATRICIA KOENIG

Surveyed APRIL 6, 1961, by C. C. Bartels