


T.7S.R.1W.W.M.

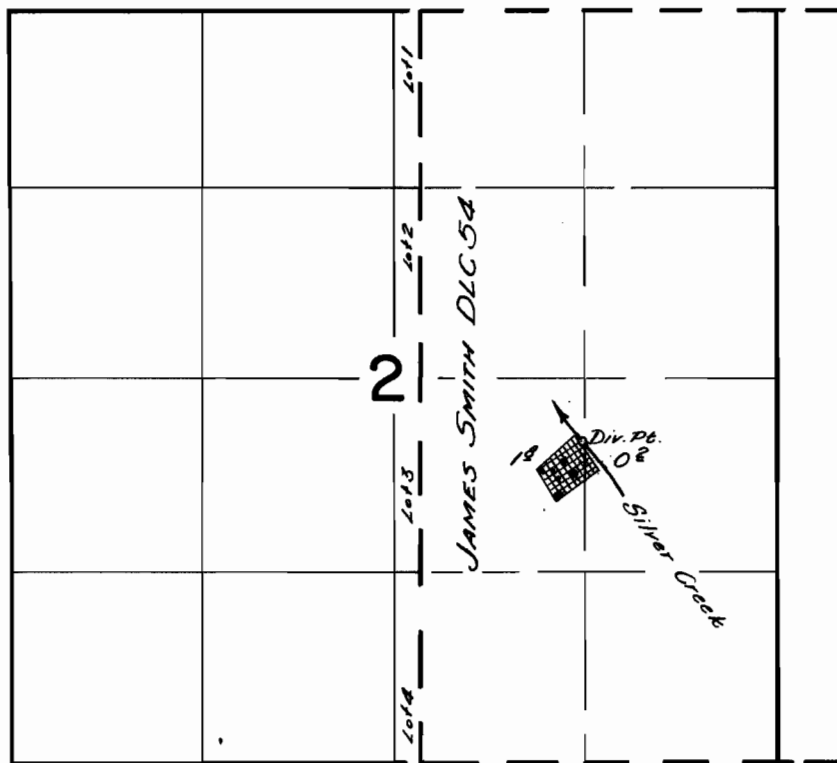

FINAL PROOF SURVEY UNDER

Application No. 33748 Permit No. 26650
IN NAME OF

FLOYD MATTHEWS

Surveyed MARCH 30 1961, by COBART