


# T. 6 S. R. 1 W. W. M.

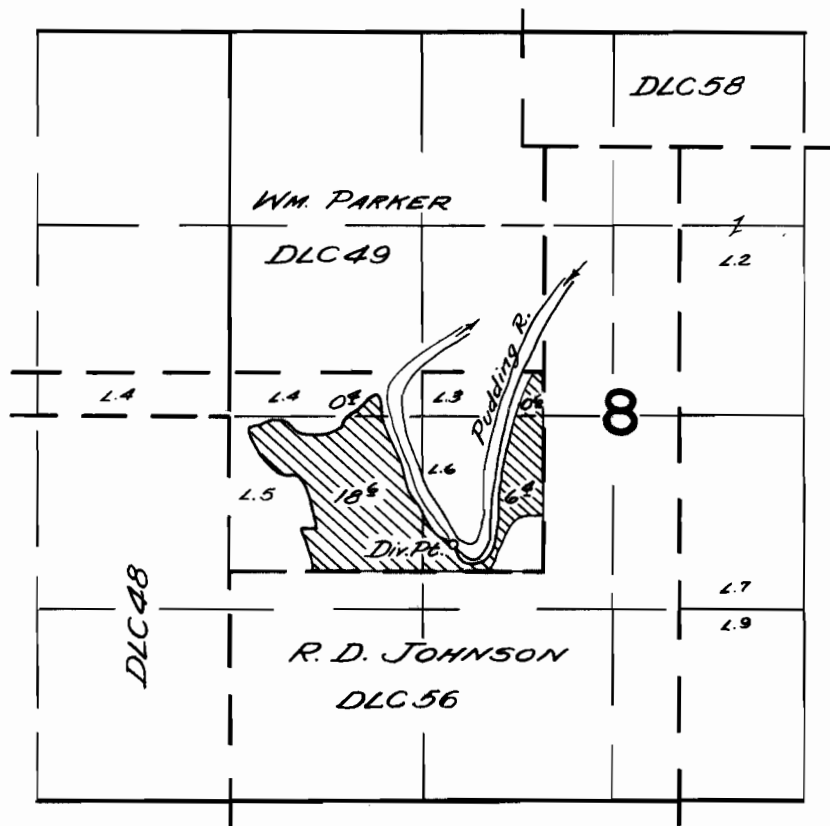

## FINAL PROOF SURVEY UNDER

Application No. 33935 Permit No. 26815  
IN NAME OF

GEORGE W. WIESNER

Surveyed MARCH 31 1961, by CHAS. H. WILSON