


T. 9 S. R. 4 W. W. M.

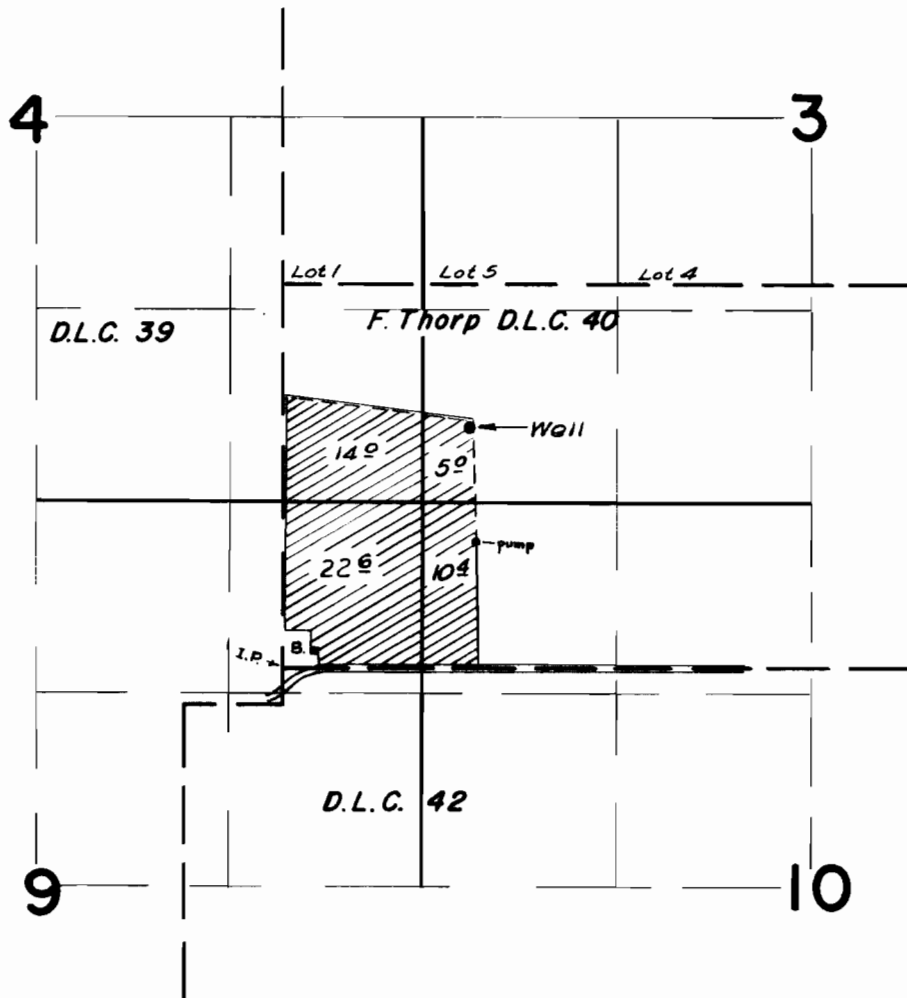

FINAL PROOF SURVEY UNDER

Application No. G-707 Permit No. G-604
IN NAME OF

CHARLES S. & GOLDA V. BOWMAN

Surveyed 31 MAR. 1961, by Mr. Bish