


T7SR4&5 W.W.M.

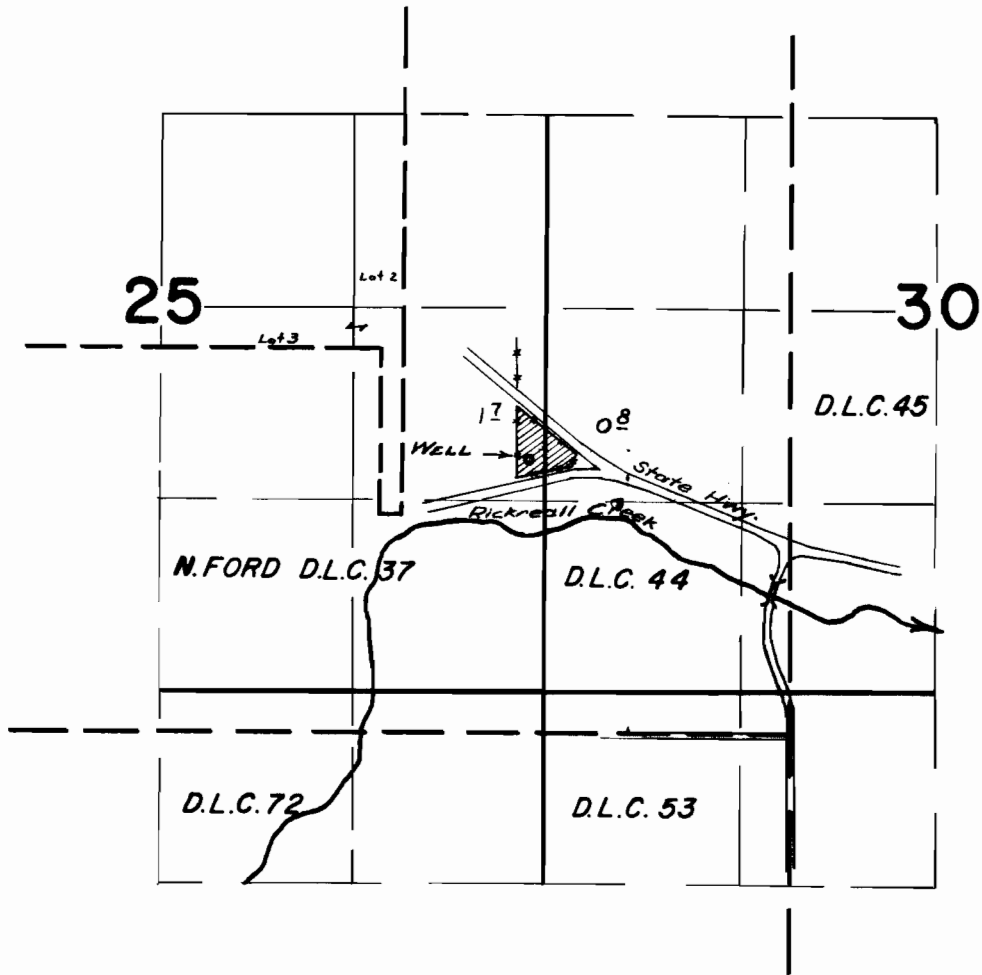

FINAL PROOF SURVEY UNDER

Application No. *G-1065* Permit No. *G-936*
IN NAME OF

MERRITT E. HART

Surveyed *24 MAR. 1961*, by *m. Bish*