


T.7S.R.4 W.W.M.

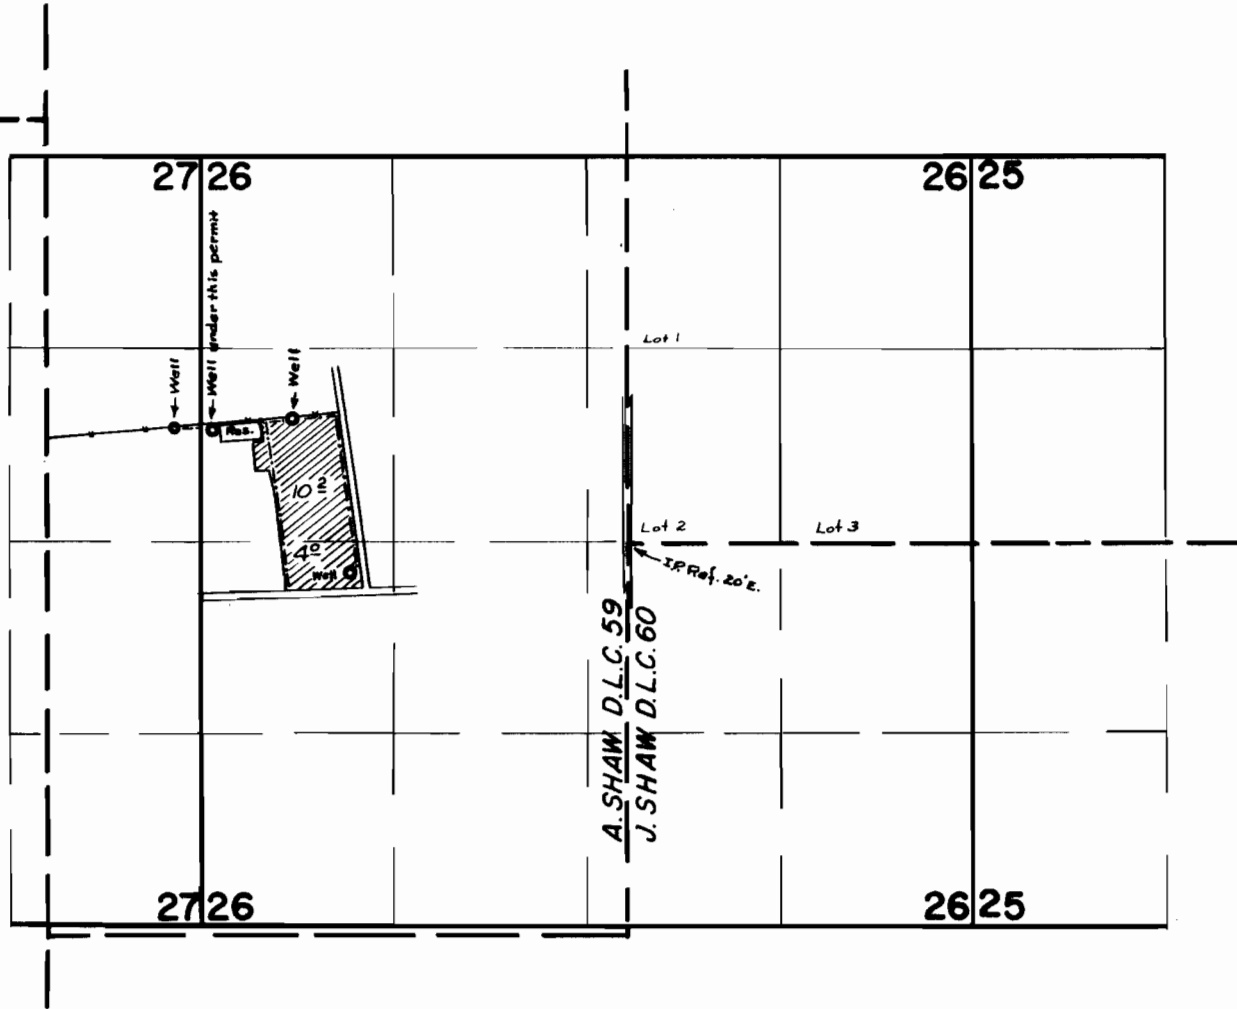

FINAL PROOF SURVEY UNDER

Application No. G-1114 Permit No. G-1097
IN NAME OF

RESTLAWN MEMORY GARDENS

Surveyed 23 MAR. 1961, by M. Bish