


T. 10 S. R. 5 W. W. M.

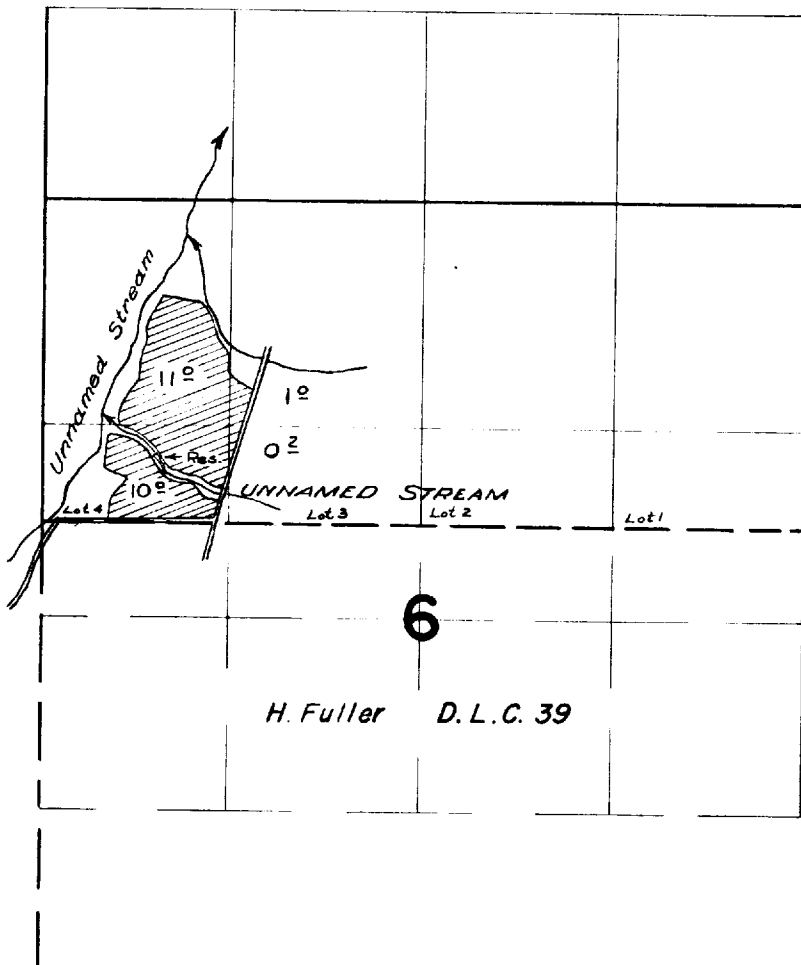

FINAL PROOF SURVEY UNDER

Application No. 30082 R-30081 Permit No. 23708 R-1768
IN NAME OF

HAROLD JOHNSON

Surveyed 31 MAR 1961, by M. B. [Signature]