


# T. 10S. R. 5 W.W.M.

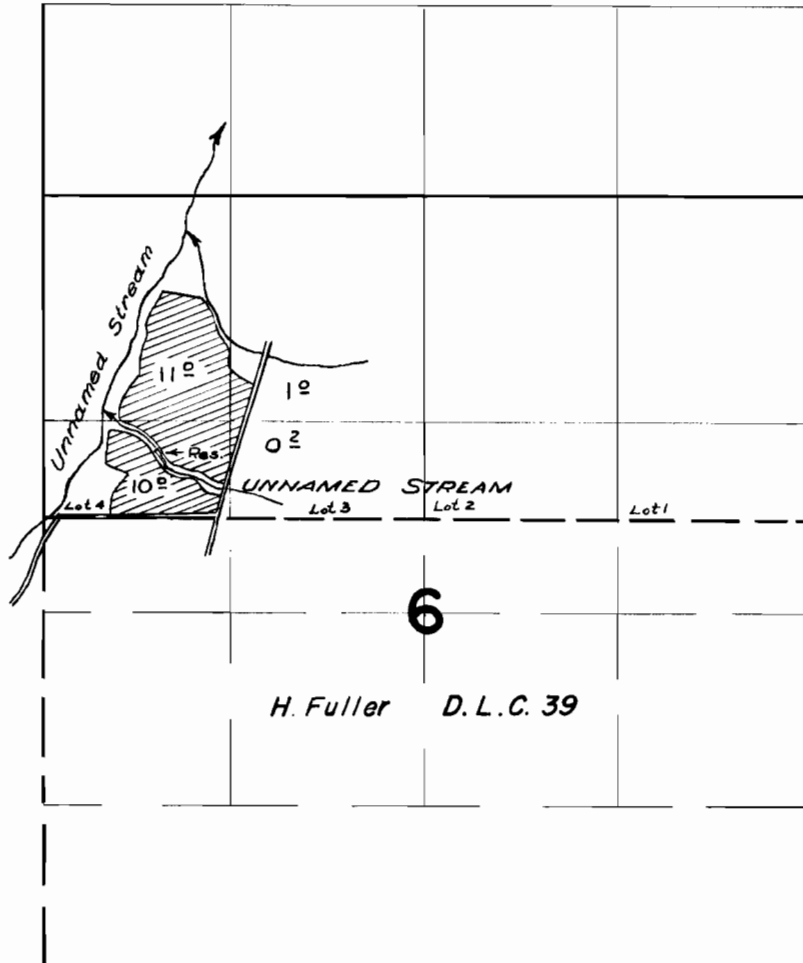

## FINAL PROOF SURVEY UNDER

Application No. 30082 R-30081 Permit No. 23708 P-1768  
IN NAME OF

HAROLD JOHNSON

Surveyed 31 MAR 1961, by m. Bish